



RECEIVED

SEP - 4 1997

WATER RESOURCES DEPT.
SALEM, OREGON

FOUND EVIDENCE OF OLD
BARBED WIRE FENCE CORNER
ASSUMED TO BE NW CORNER
OF SE 1/4 SE 1/4


N
1" = 400'
T5W R43E WM
WALLOWA COUNTY

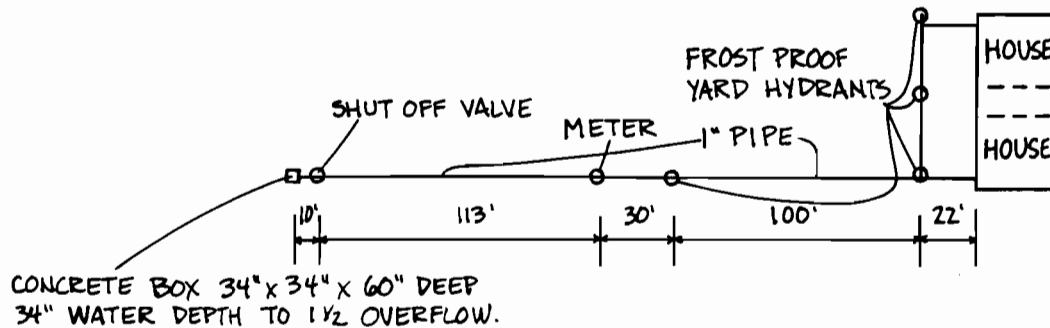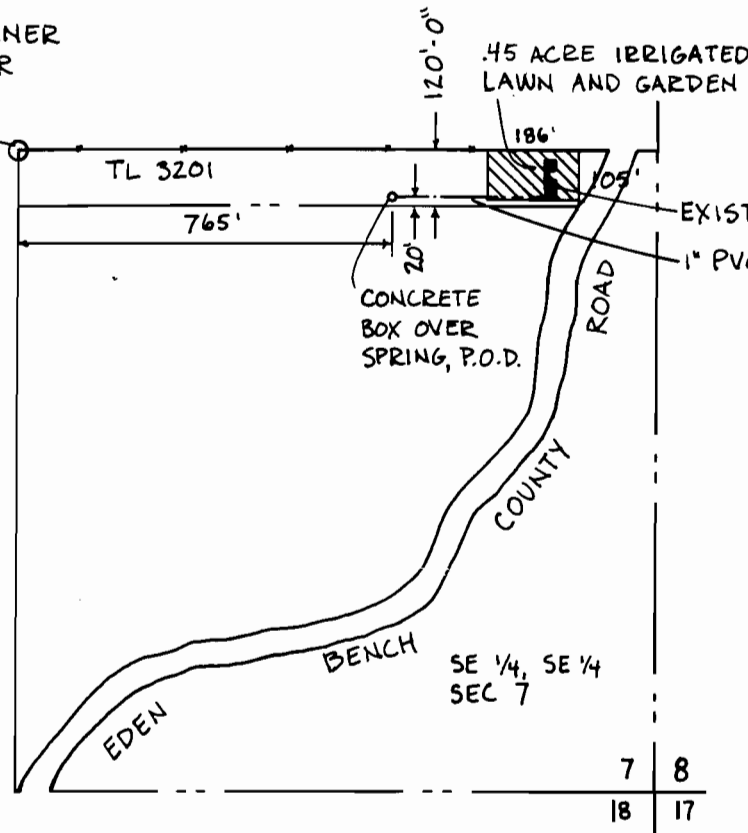

CONCRETE BOX 34" X 34" X 60" DEEP
34" WATER DEPTH TO 1 1/2" OVERFLOW.

ENLARGEMENT OF SPRING DEVELOPMENT, NTS

THIS MAP WAS PREPARED FOR THE PURPOSE
OF IDENTIFYING THE LOCATION OF THE
WATER RIGHT ONLY. THERE IS NO INTENT TO
PROVIDE DIMENSIONS OR LOCATIONS OF
PROPERTY OWNERSHIP LINES.

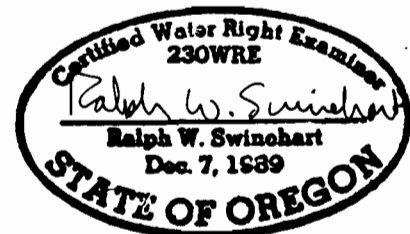

FINAL PROOF SURVEY MAP
PERMIT 52398
FOR: RALPH E. MILTON

DATE 8/97
JOB 97813
DESIGN RWS
DRAWN TCB

**WALLOWA MOUNTAIN
ENGINEERING**
PO BOX 266
ENTERPRISE, OREGON 97825
426-4884

REVISIONS
SHEET 1 OF 1