


4
N

T.39S.,R.7W.,W.M.
SECTION 24


RECEIVED

MAR 7 2000

WATER RESOURCES DEPT.
SALEM, OREGON

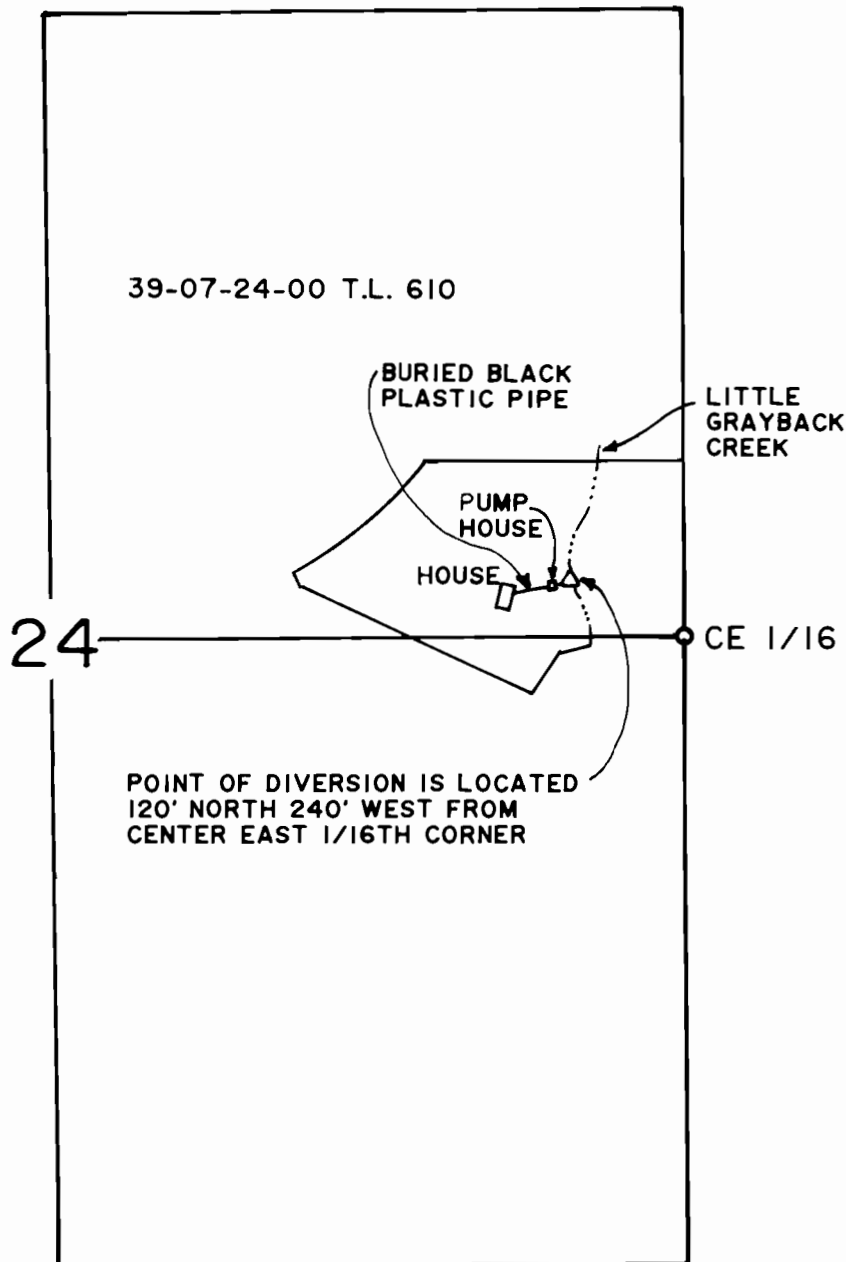

PREPARED BY:
JONATHAN C. SPERO C.W.R.E. 123
1002 KINCAID RD./P.O. BOX 16
WILLIAMS, OREGON 97544
PH. (541) 846-6845

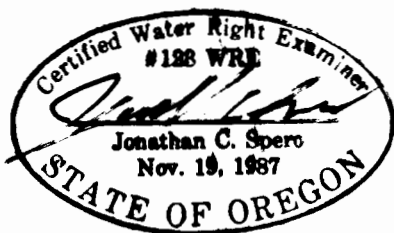

LICENSE RENEWAL DATE:
JUNE 30, 2000

**FINAL PROOF SURVEY
UNDER**

APPLICATION NO. S-72148 PERMIT NO. 52136

**IN THE NAME OF
RUDY AND OLGA TREVINO**

SURVEYED FEB. 17, 2000 JONATHAN C. SPERO

THIS MAP IS FOR THE PURPOSE OF
IDENTIFYING THE LOCATION OF THE
WATER RIGHT ONLY, AND IS NOT IN-
TENDED TO PROVIDE LEGAL DIMEN-
SIONS OR LOCATIONS OF PROPERTY
OWNERSHIP LINES.

SCALE: 1" = 400'