


May Queen Ditch

Scale 4"=1 Mile

Aug. 1928


Profile of Pipe Line

Scale 400'=1"

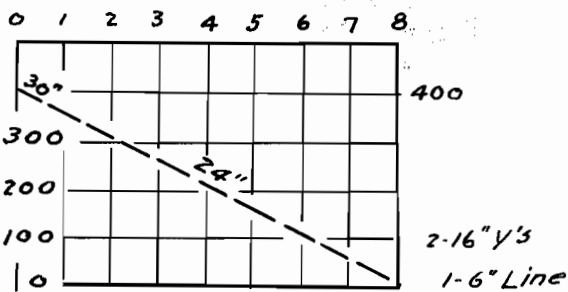


28

27

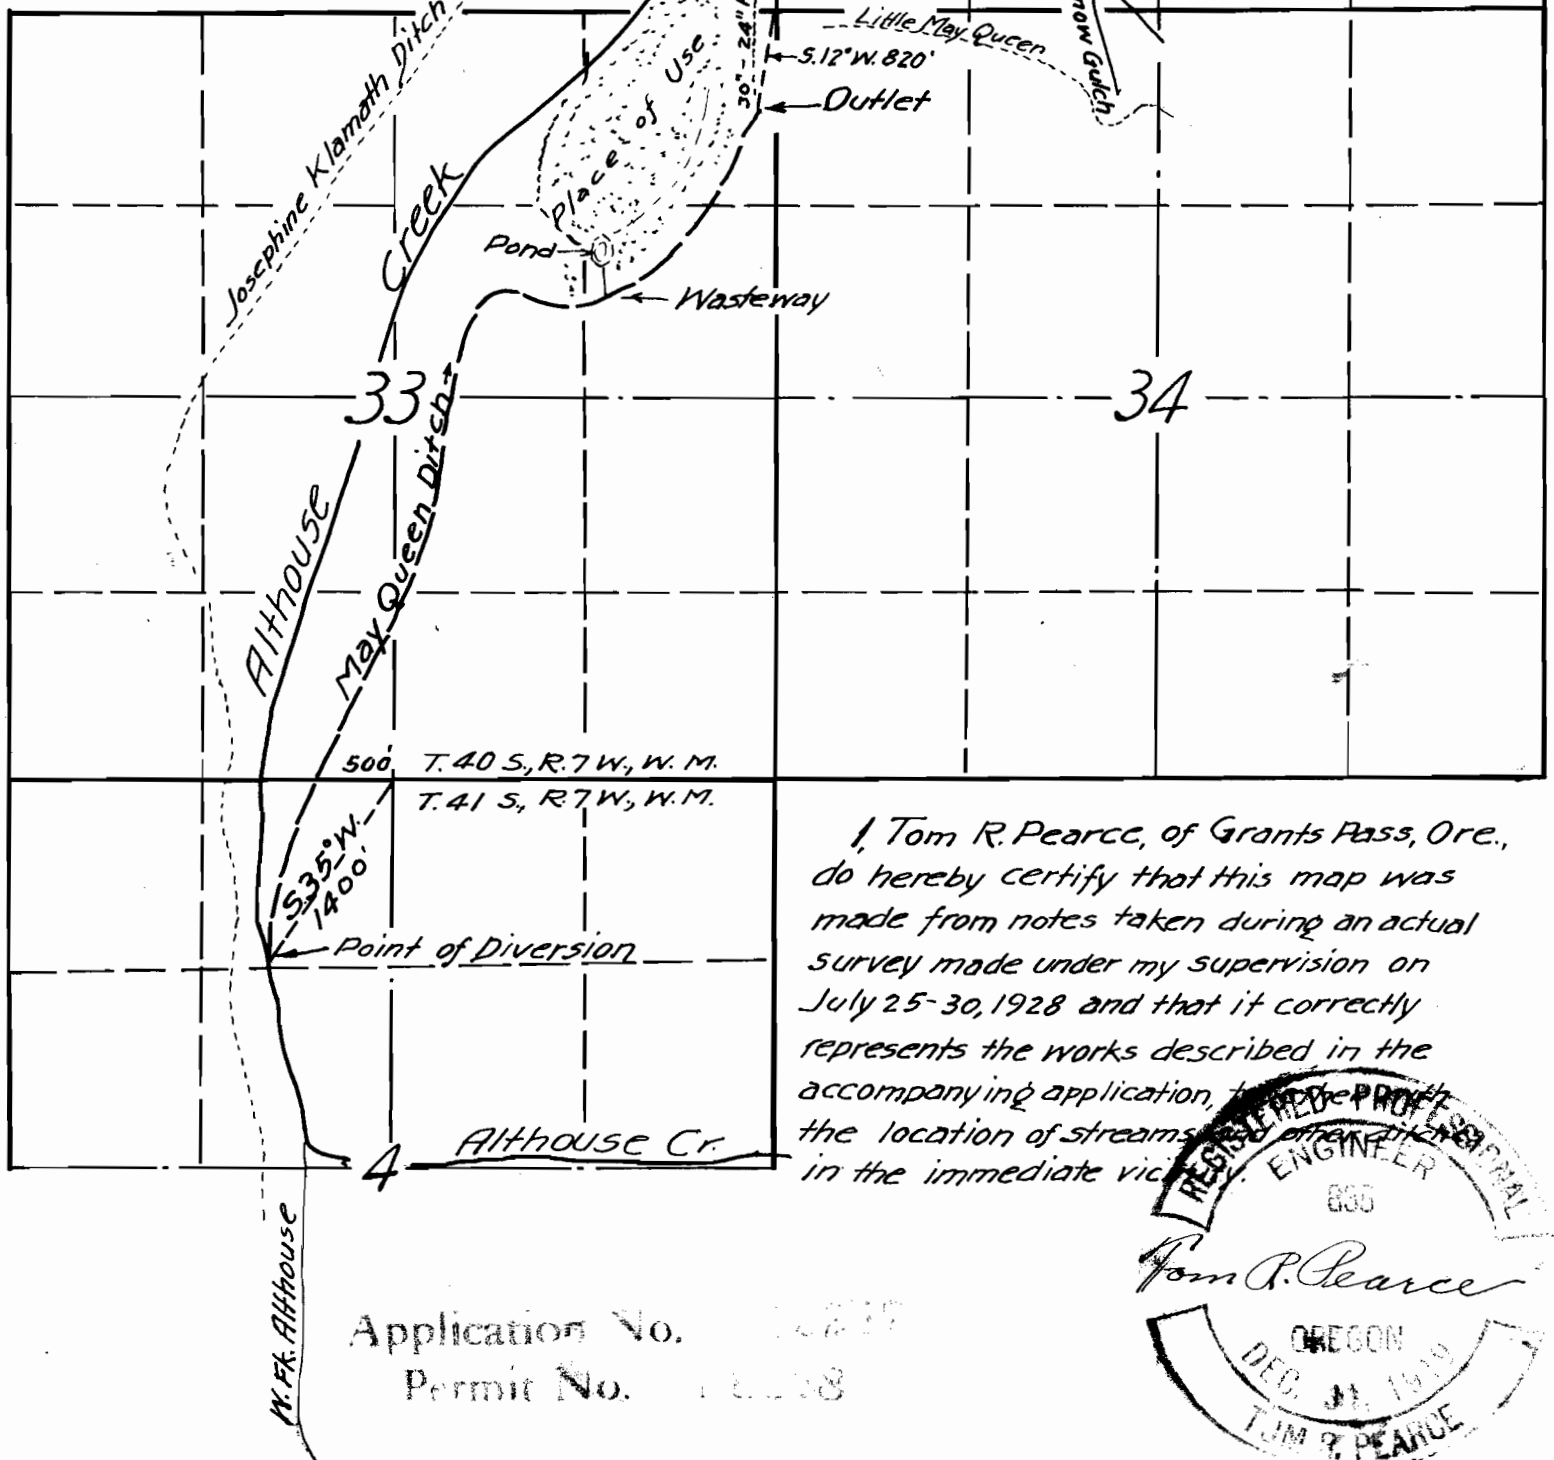

I, Tom R. Pearce, of Grants Pass, Ore., do hereby certify that this map was made from notes taken during an actual survey made under my supervision on July 25-30, 1928 and that it correctly represents the works described in the accompanying application, the location of streams in the immediate vicinity.

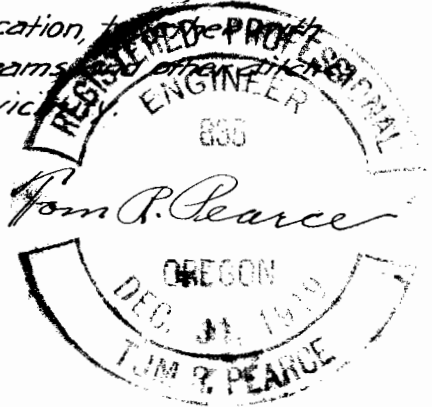

Application No. 12237
Permit No. 12238