


T. 7S., R. 44E., W.M.

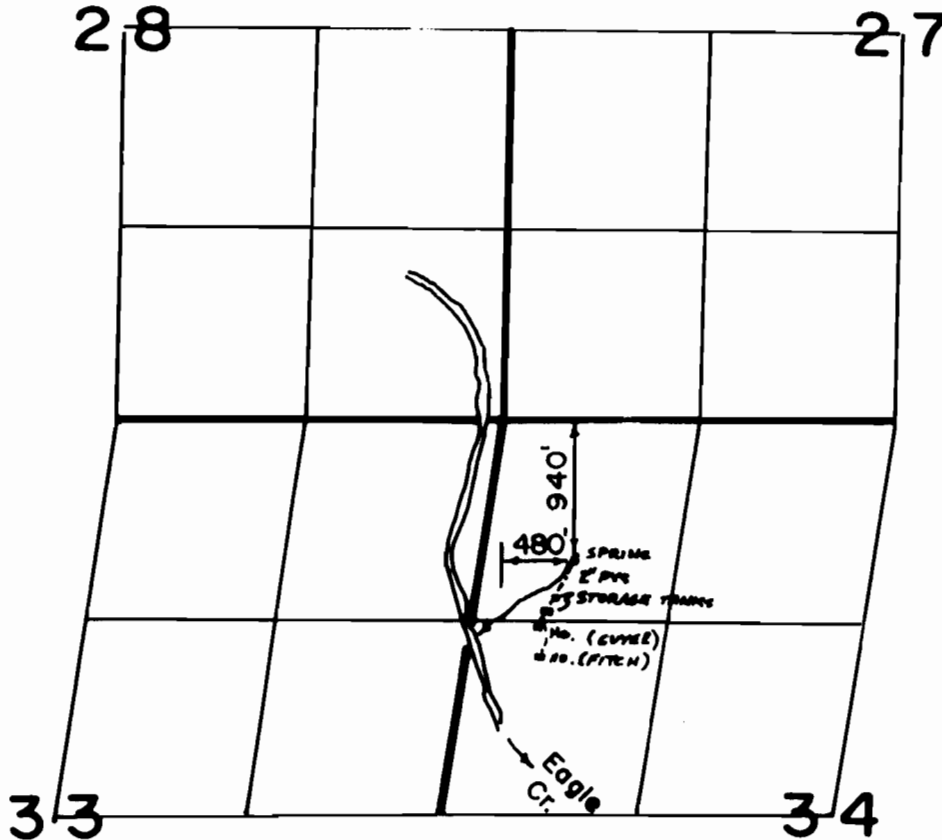

SCALE 1" = 1320'

The purpose of this map is for identifying the location of the water right only and is not intended to provide legal dimensions of property ownership lines.

FINAL PROOF SURVEY

APPL. 72260

PER. 52786

IN NAME OF

Randell Guyer, Jr. and H.F. Fitch

SURVEYED SEPT. 15, 2000

RECEIVED

OCT 02 2000

WATER RESOURCES DEPT.
SALEM, OREGON

