


SEC. 11, T28S, R12W WM

JUN 18 1998

WATER RESOURCES DEPT
STATE OF OREGON

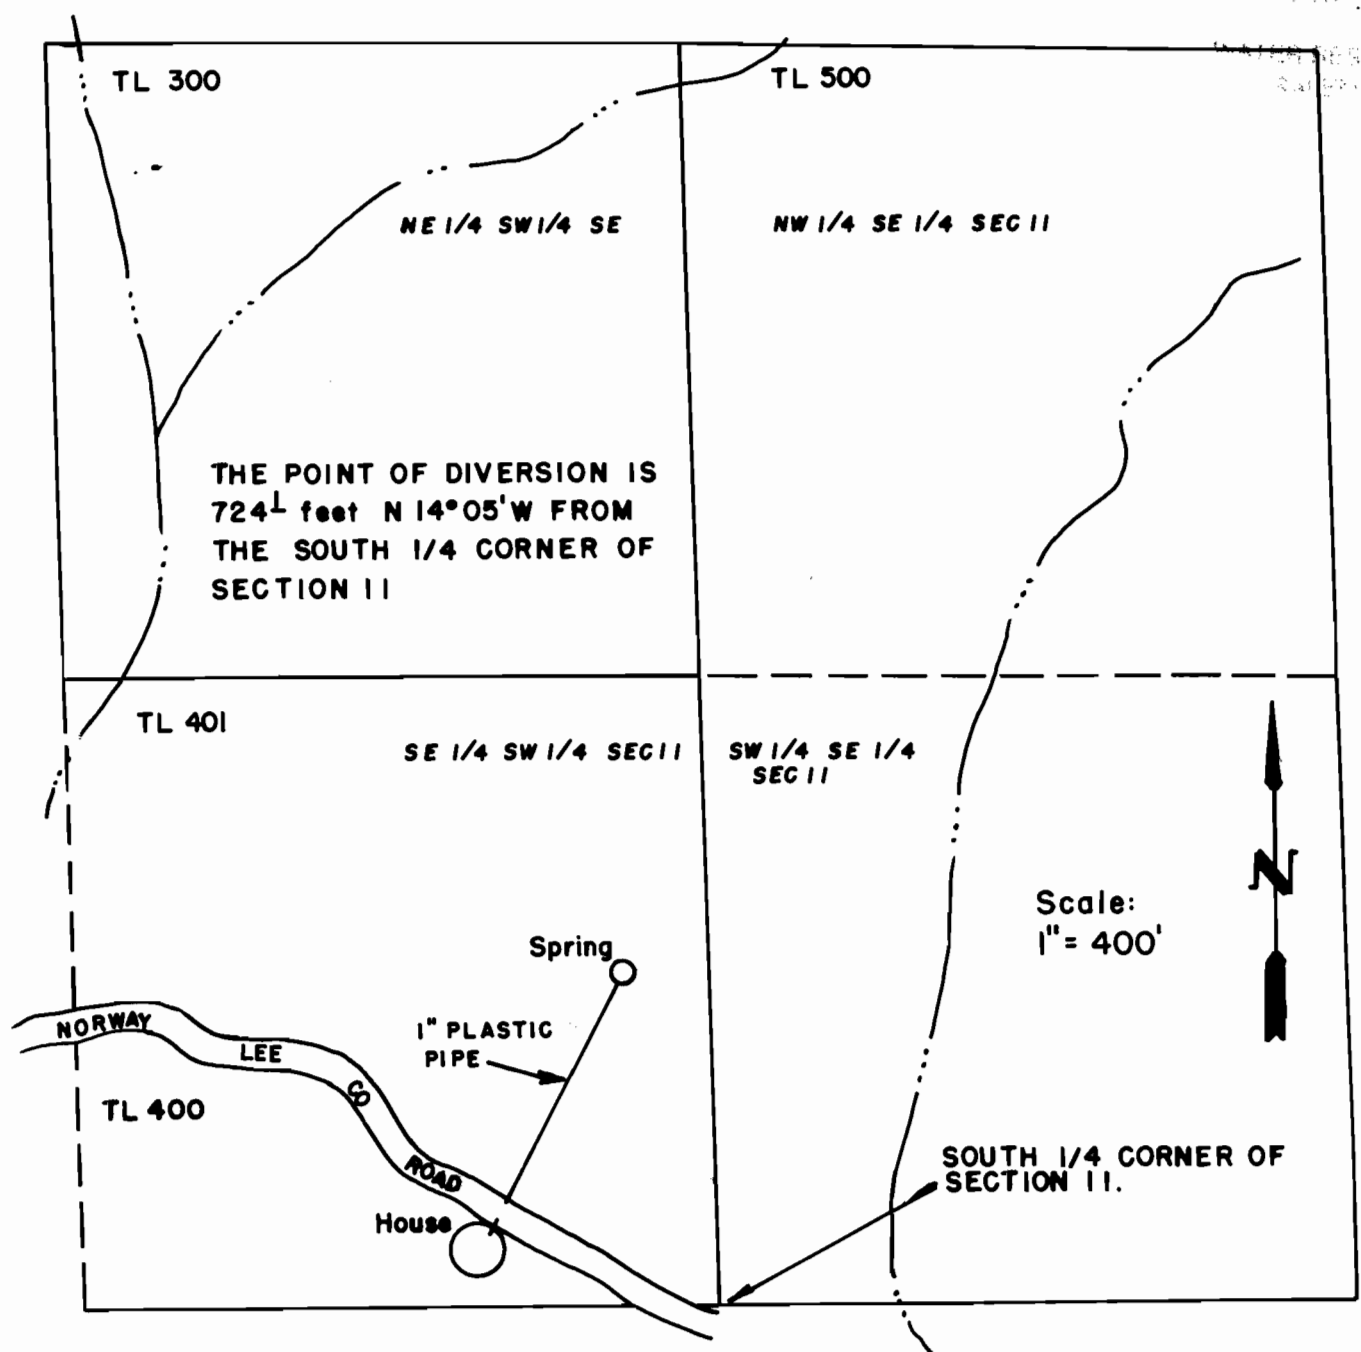

FINAL PROOF SURVEY UNDER



Application No. S-72308 Permit No. 51909.

DEAN & DEE MOREY.

Surveyed 3-28, 1998 by K. Phelps.