


SEC. 14 & 15 T11S R20E W.M.

APPLICATION 5-72387

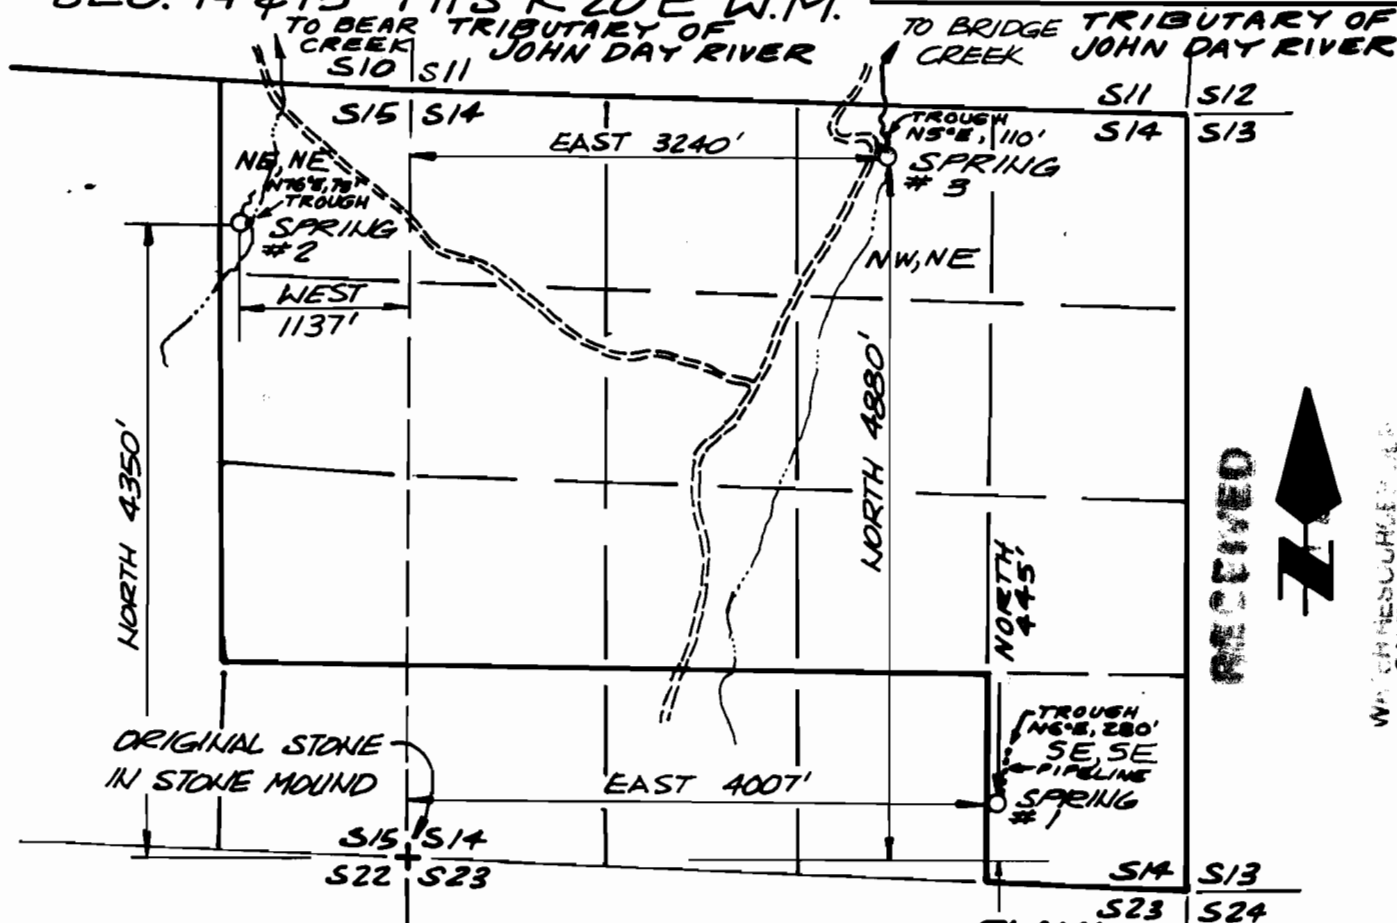

SURVEY NOTE

THE PREPARATION OF THIS MAP IS FOR THE PURPOSE OF IDENTIFYING THE LOCATION OF THE WATER RIGHT ONLY AND HAS NO INTENT TO PROVIDE DIMENSIONS OR LOCATIONS OF PROPERTY OWNERSHIP LINES.

NOTE

SPRINGS WERE TIED TO SW CORNER OF SECTION 14, T.11S., R.20E., W.M., ON MARCH 20, 1992, BY FIELD SURVEY.

CLAIM OF BENEFICIAL USE PREPARED FOR

EDMLIND C. NORTON JR.
BETTY JO NORTON
BOX 336 BURNTRANCH
ROUTE
MITCHELL, OR. 97750
(541) 462-3355


LEGEND

FROM COR. COMMON TO SEC. 14, 15, 22 & 23, T.11S., R.20E., W.M.

Q SPRING #1 N. 445'
E. 4007'
Q SPRING #2 N. 4350'
W. 1137'
Q SPRING #3 N. 4880'
E. 3240'

ARMSTRONG SURVEYING
& ENGINEERING, INC.
378 EAST SECOND ST.
PRINEVILLE, OR. 97754
(541) 447-7791

F.B. 43

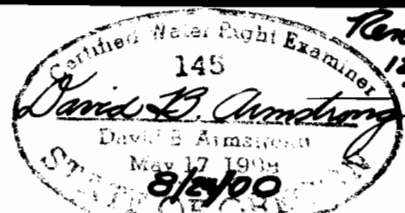

SCALE: 1" = 1320'

DATE: 8-24-00

W.O. 99-1968