
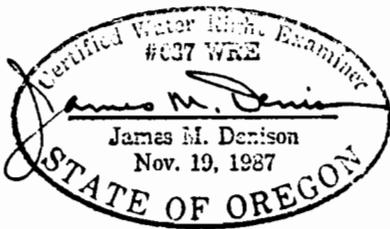


T8S. R10W., W.M.  
NW1/4 - SE1/4 SECTION 4  
SE1/4 SECTION 4  
LINCOLN COUNTY, OREGON  
Scale: 1 inch = 1320 feet

**RECEIVED**

OCT 01 1998

WATER RESOURCES DEPT.  
SALEM, OREGON

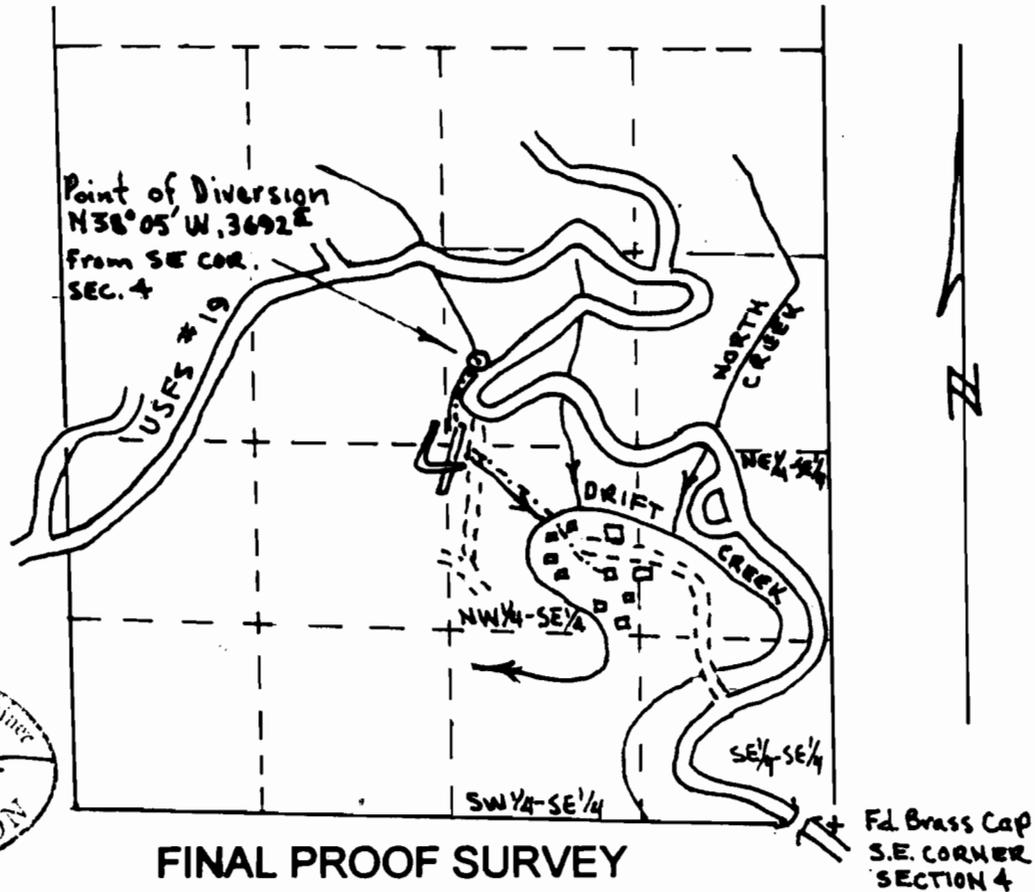

**FINAL PROOF SURVEY  
UNDER**

APPLICATION # 72580

PERMIT # 51566

IN THE NAME OF

**MENNONITE CAMP ASSOCIATION OF OREGON, INC.**

SURVEYED: September 29, 1998

BY: J. M. DENISON

THIS MAP PREPARED SOLEY FOR THE PURPOSE OF SHOWING LOCATION OF A WATER RIGHT, AND IS NOT INTENDED FOR USE FOR PROVIDE DIMENSIONS OR LOCATION OF PROPERTY OWNERSHIP LINES.