


# SECTION 19, T26S, R4W, WM

THIS MAP IS TO BE USED FOR WATER RIGHT PURPOSES ONLY.

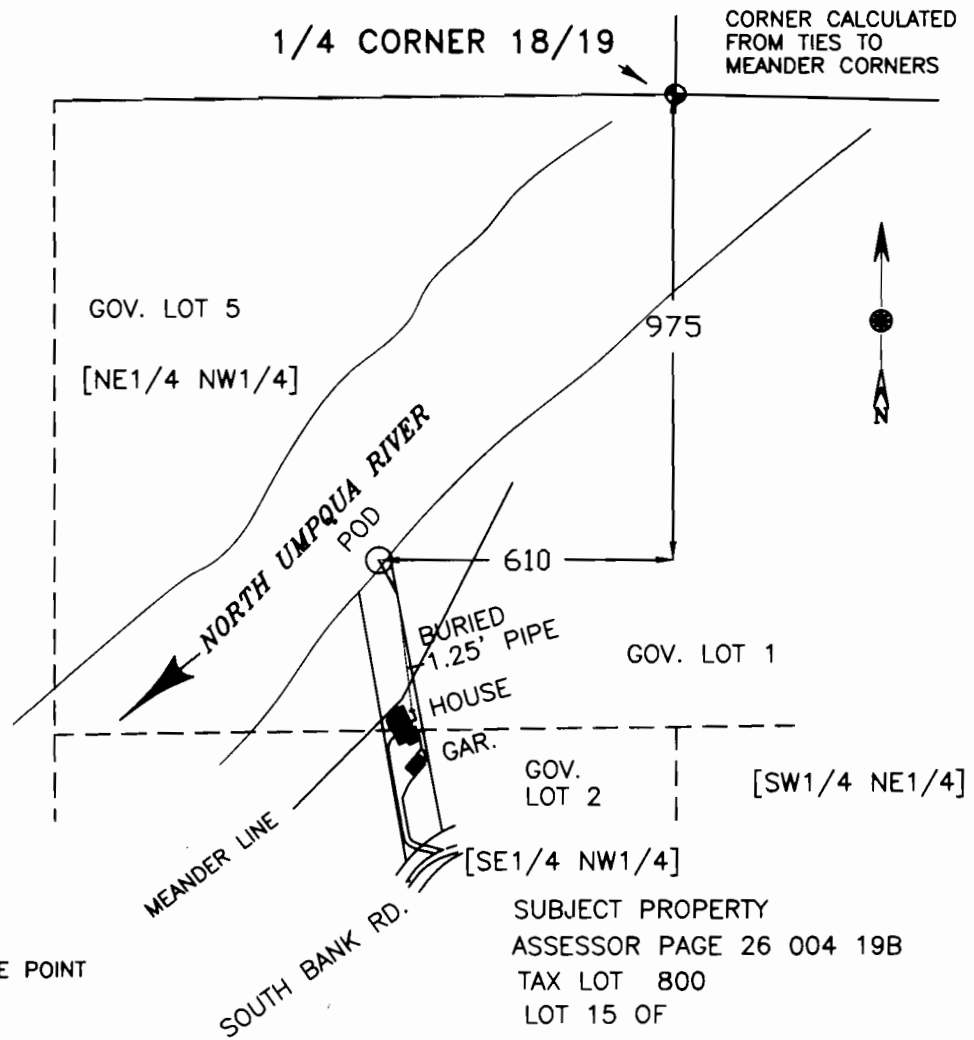


MAP BASED ON EAGLE POINT ESTATES SUBDIVISION.

SUBJECT PROPERTY  
ASSESSOR PAGE 26 004 19B  
TAX LOT 800  
LOT 15 OF  
EAGLE POINT ESTATES

MAP TO ACCOMPANY CLAIM OF BENEFICIAL USE FOR WATER PERMIT S-54310, APPL. S-86328

IN NAME OF  
**Loyd Price**

BY: WILLIAM J. RUPPERT  
P.O. BOX 1564  
MYRTLE CREEK, OR 97457  
9-28-06

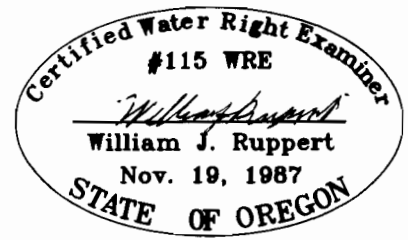

EXPIRES 12-31-08

**RECEIVED**

MAR 08 2007  
WATER RESOURCES DEPT  
SALEM OREGON