

T. 26 S., R 13 W., W.M.


23/24
26/25

NW

N 1/4

This map is not intended to provide legal dimensions or locations of property ownership lines.

TL 1500 (PLACE OF USE)

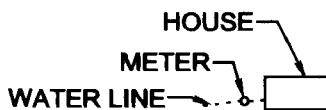


TL 1700

TL 1800

SMALL
UN-NAMED
STREAM
TRIBUTARY OF
ISTHMUS SLOUGH

POINT OF DIVERSION
1828 FT. SOUTH
1639 FT. EAST
OF NW CORNER OF
SECTION 25

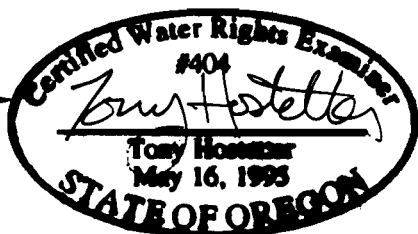

SE 1/4, NW 1/4

W 1/4

C 1/4

POINT OF DIVERSION
DIV. PT. LOCATED 1828 FT. SOUTH & 1638' EAST,
FROM THE NW CORNER OF SECTION 25

RECEIVED

SCALE: 1"=400'
FINAL PROOF SURVEY

JUN 25 2007

UNDER

WATER RESOURCES DEPT
SALEM, OREGON

Application No. S-85076 Permit No. 53842
IN THE NAME OF
CHARLES E. AND DANA L. SANDERS
Surveyed May 8, 2007, by T.HOSTETTER