

RECEIVED

DEC 31 2007

WATER RESOURCES DEPT
SALEM, OREGON


CLAIM OF BENEFICIAL USE
APPLICATION NO. 84952
PERMIT NO. 5-53891
SURVEY BY DUANE KIRBY
FOR CLAYTON AND MYRNA JUDD
T25S, R7W, W.M.
SECTION 21, TAXLOT 600
SCALE: 1" = 400'

16

15

21

22

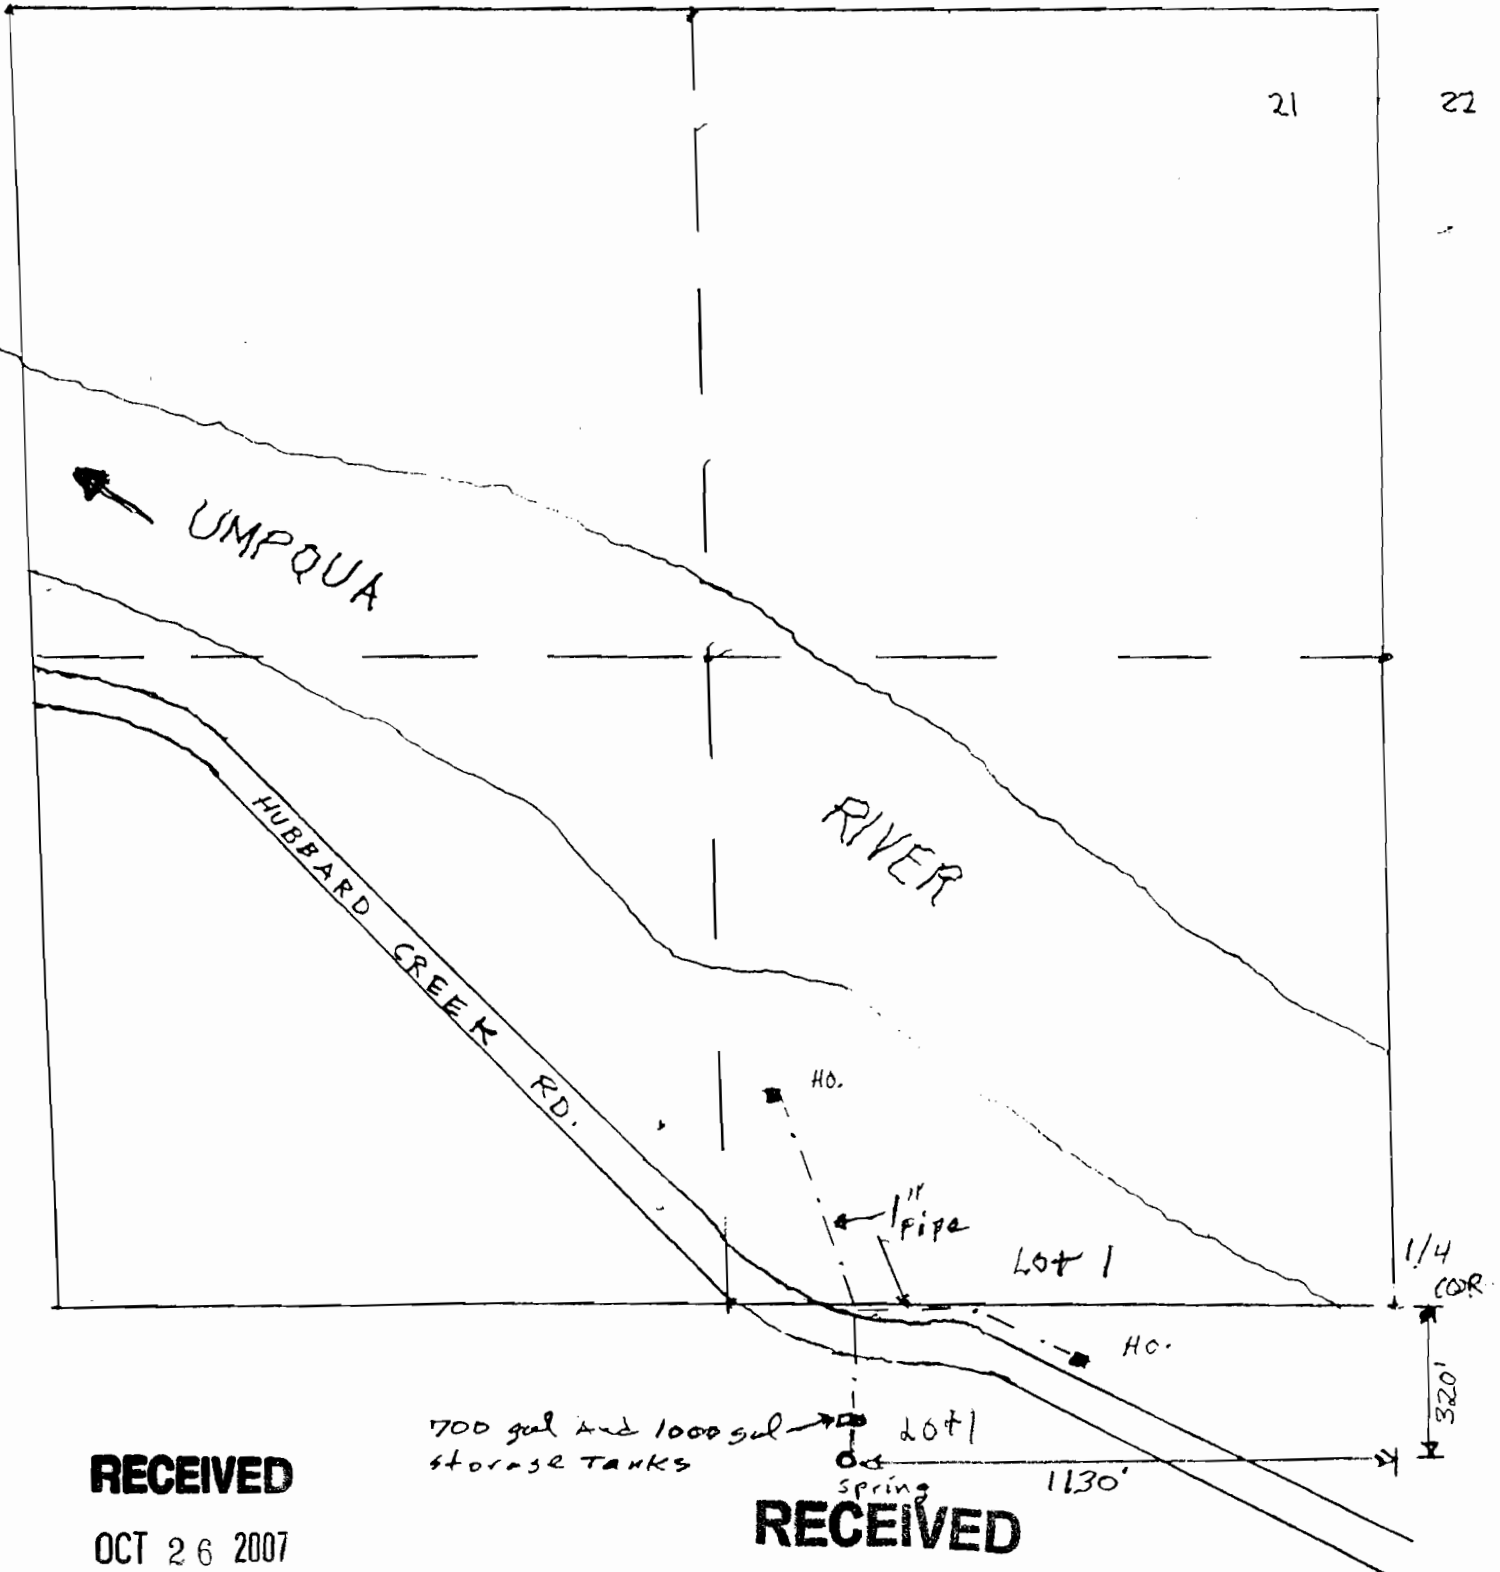

RECEIVED

OCT 26 2007

WATER RESOURCES DEPT
SALEM, OREGON

THE PURPOSE OF THIS MAP IS TO IDENTIFY THE LOCATION OF THE WATER RIGHT. IT IS NOT INTENDED TO PROVIDE LEGAL DIMENSIONS OR THE LOCATION OF PROPERTY OWNERSHIP LINES.

RECEIVED

SEP 27 2007

WATER RESOURCES DEPT
SALEM OREGON

