


CLAIM OF BENEFICIAL USE  
FOR  
EDGAR CHEVALIER  
BETH CHEVALIER  
T30S, R2WW.M.  
SECTION 23



APPLICATION NO. S-83915  
PERMIT NO. 53613

SCALE 1" = 400'

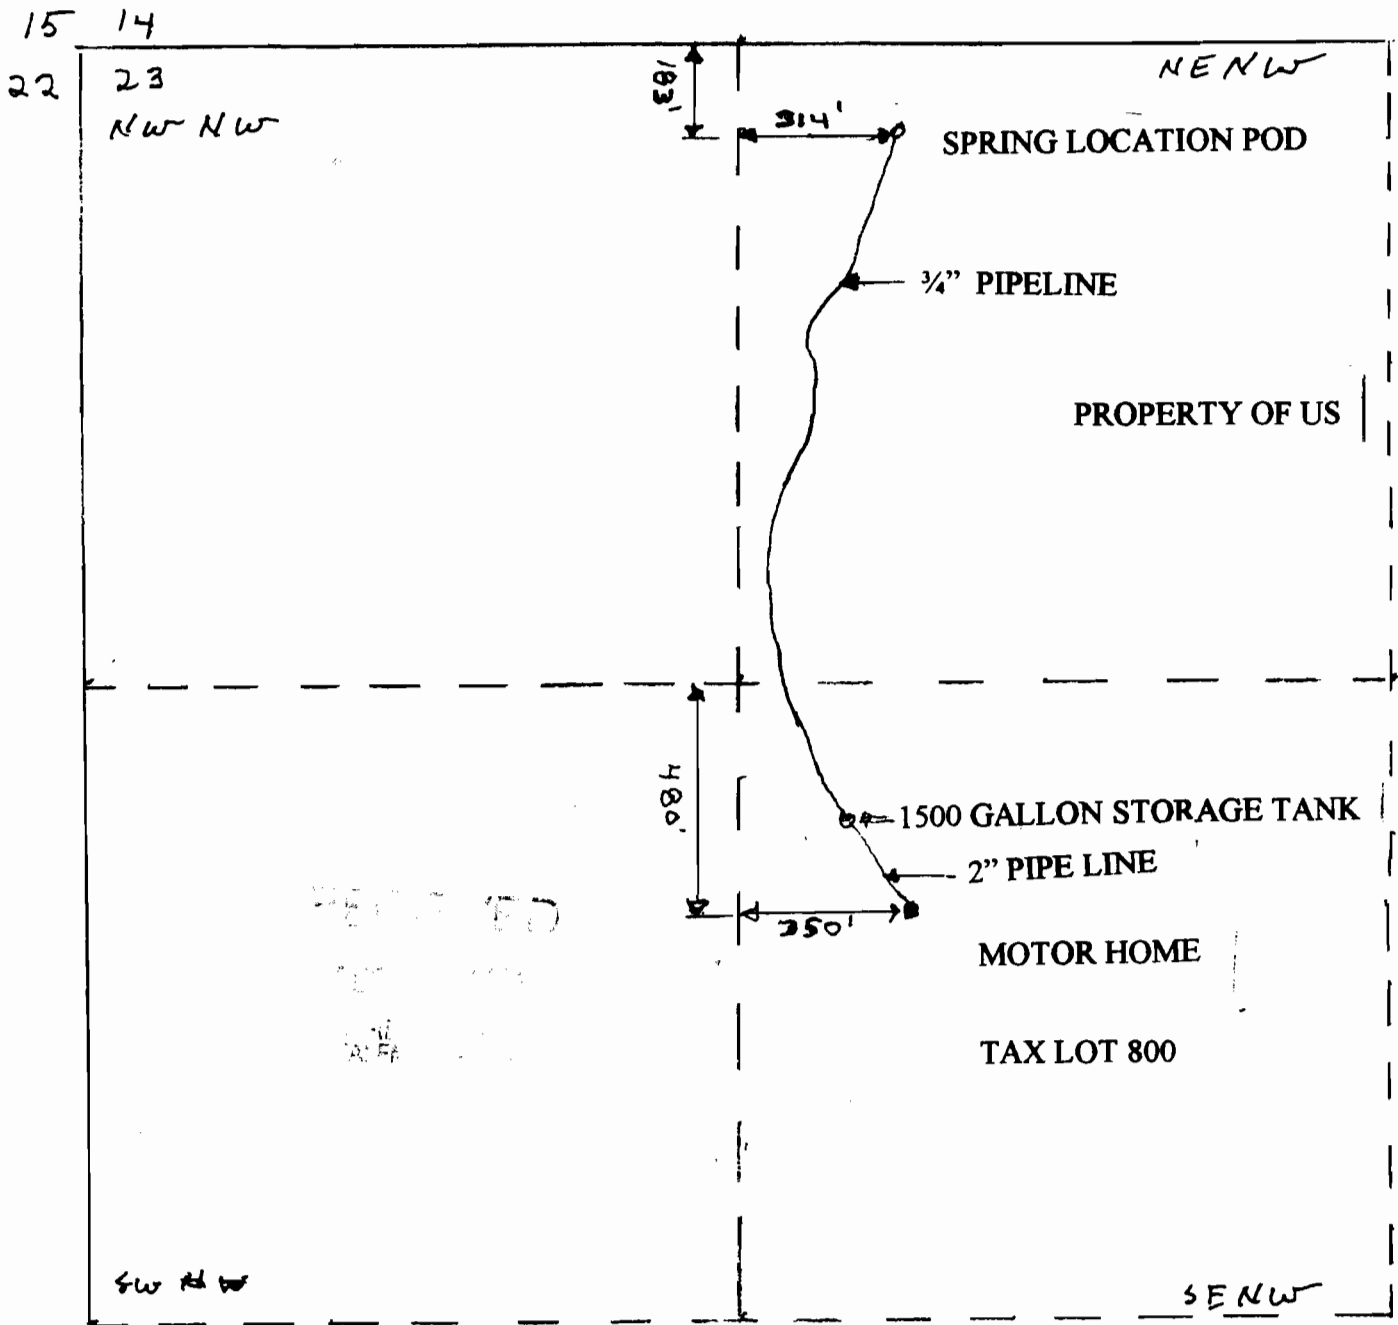

THE PURPOSE OF THIS MAP IS TO IDENTIFY THE LOCATION OF THE WATER RIGHT. IT IS NOT INTENDED TO PROVIDE INFORMATION RELATIVE TO THE LOCATION OF PROPERTY OWNERSHIP BOUNDARY LINES.

