

SECTION 23, T.5N., R.3W., W.M.
COLUMBIA COUNTY, OREGON

RECEIVED

SEP - 3 1997

WATER RESOURCES DEPT.
SALEM, OREGON

T.L. 100 MI


1480'

2395'

PREPARATION OF THIS MAP IS FOR THE
PURPOSE OF IDENTIFYING THE LOCATION OF
THE WATER RIGHT ONLY. THERE IS NO INTENT
TO PROVIDE DIMENSIONS OR LOCATION OF
PROPERTY OWNERSHIP LINES.

N
SCALE: 1" = 400'

CERTIFICATE MAP
SURVEYED 8-18-97

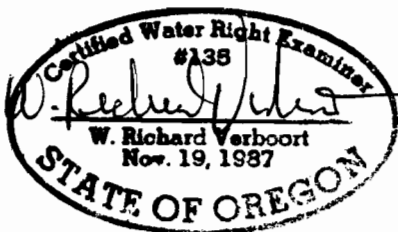

APPLICATION R-69901, 69902
PERMIT R-11164, 50760

23

24

26

25

VERBOORT ENGINEERING
AGRICULTURE • CIVIL • WATER RESOURCES
HILLSBORO, OREGON

BY DATE
DESIGNED WRV 8-97
DRAWN JER 8-97
CHECKED WRV 8-97
DRAWING No. 97-A-08
SHEET No. 1/1

RUDOLPH M. BAUDER
26000 PITTSBURG ROAD
ST. HELENS, OR 97051