


CLAIM OF BENEFICIAL USE

SOUTHEAST QUARTER OF SECTION 3,
TOWNSHIP 40 SOUTH, RANGE 14 WEST,
WILLAMETTE MERIDIAN,
CURRY COUNTY, OREGON

RECEIVED

APR 7 1999

WATER RESOURCE DEPT.
SALEM, OREGON

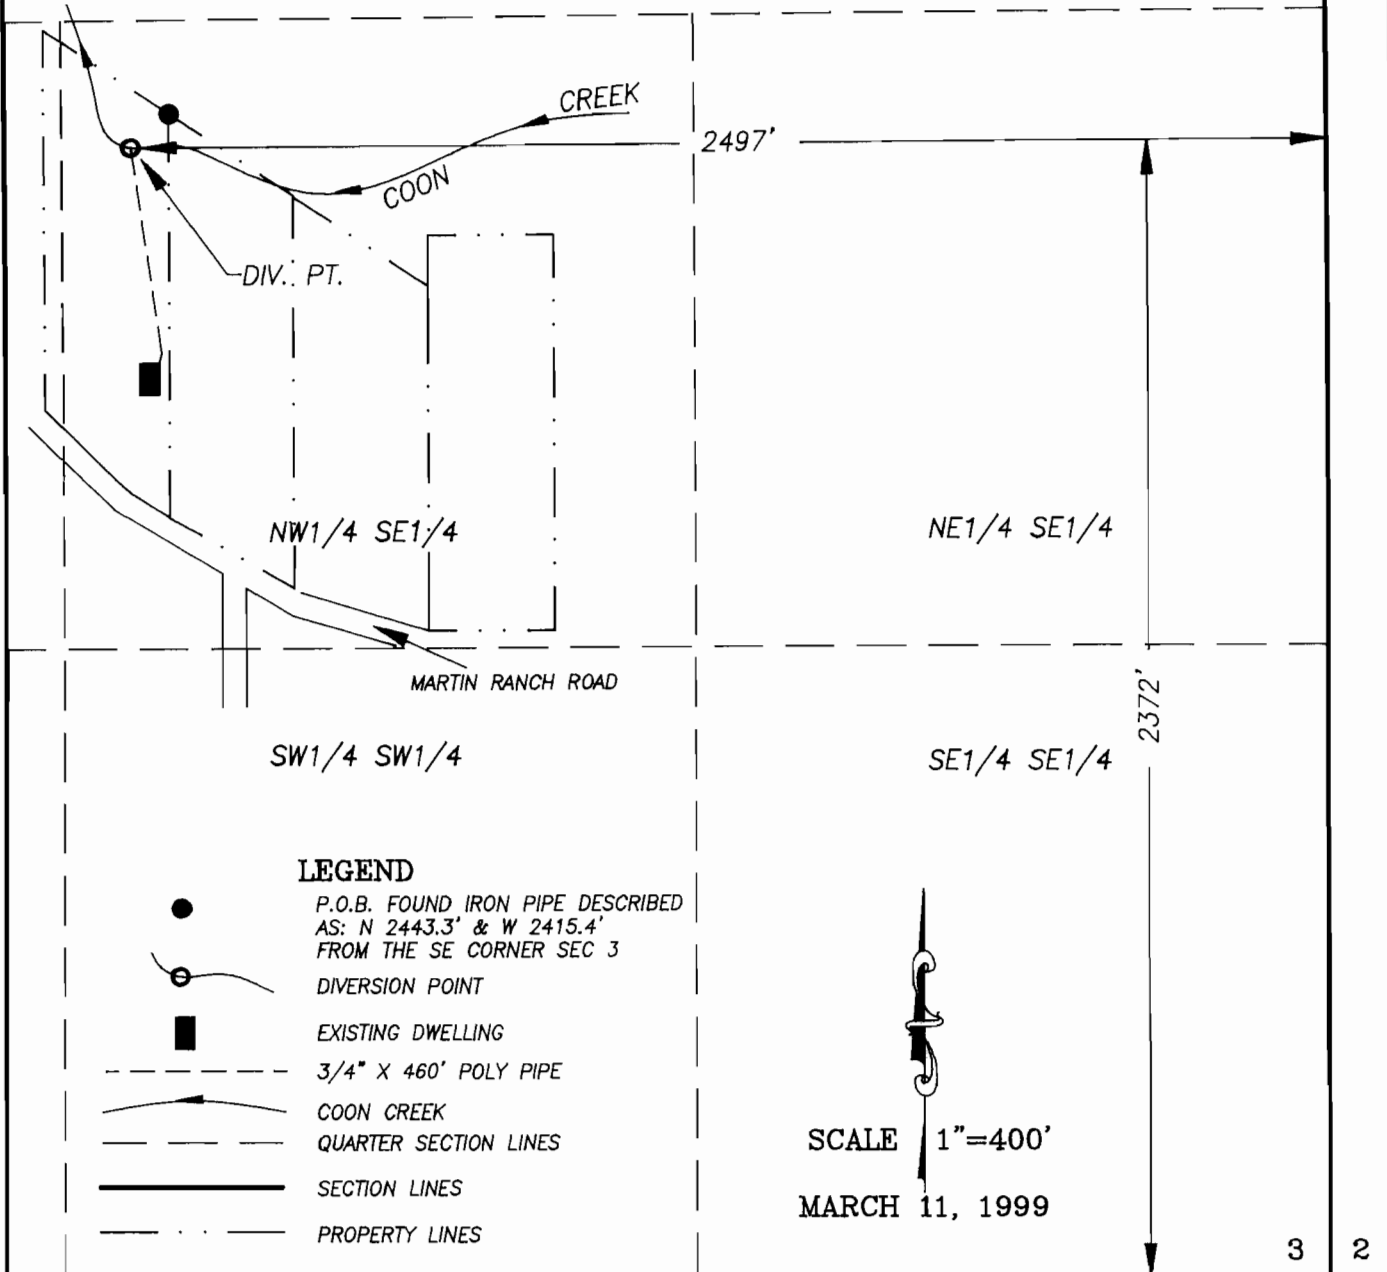

CLAIM OF BENEFICIAL USE

under

APPLICATION NO. S-83769 PERMIT NO. 53516


IN THE NAME OF: CLIVE J. WILSON

SURVEYED: MARCH 11, 1999

BY: RICHARD P. ROBERTS, CWRE #448

EXAMINER'S DISCLAIMER STATEMENT

THIS MAP WAS PREPARED FOR THE SOLE PURPOSE OF IDENTIFYING THE LOCATION OF A WATER RIGHT ONLY AND IS NOT INTENDED TO PROVIDE LEGAL DIMENSIONS OR LOCATION OF PROPERTY OWNERSHIP LINES.

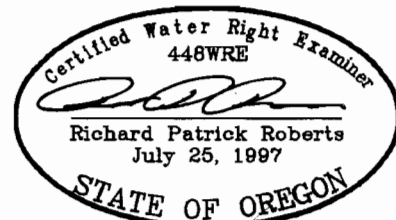

Renewal 12/31/00

Stuntzner Engineering & Forestry, LLC

ENGINEERING * LAND SURVEYING * FORESTRY * PLANNING * WATER RIGHTS

97829 Shopping Center Avenue Phone: (541) 469-5329
Post Office Box 2748 Fax: (541) 469-0768
Brookings, Oregon 97415