

THIS MAP IS FOR THE PURPOSE OF IDENTIFYING THE LOCATION OF THE WATER RIGHT ONLY. THERE IS NO INTENT TO PROVIDE DIMENSIONS OR LOCATION OF PROPERTY OWNERSHIP LINES.


## FINAL PROOF WATER RIGHTS MAP

UNDER  
PERMIT 52820  
APPLICATION 72320

NE 1/4 SW 1/4, SEC 34, T17S, R10W, W.M.  
NW 1/4 SE 1/4, SEC 34, T17S, R10W, W.M.  
LANE COUNTY, OREGON  
MAP NO. 17-10-34 TL 500

FOR: GORDON AND MARILYN CAMP  
11302 E MAPLETON RD  
MAPLETON, OREGON 97453

SUSAN MCALLISTER  
11301 E MAPLETON RD  
MAPLETON, OREGON 97453

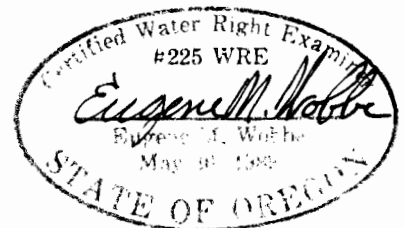

PREPARED BY: WOBBE & ASSOCIATES, INC.  
510 KINGWOOD ST. / P.O. BOX 3093  
FLORENCE, OR 97439  
DATE: SEPTEMBER 9, 1999



SCALE  
0 400