
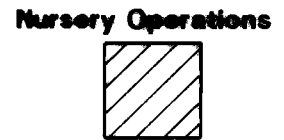


T.4S., R.1E., W.M.

RECEIVED

SEP 28 1995

WATER RESOURCES DEPT.
SALEM, OREGON

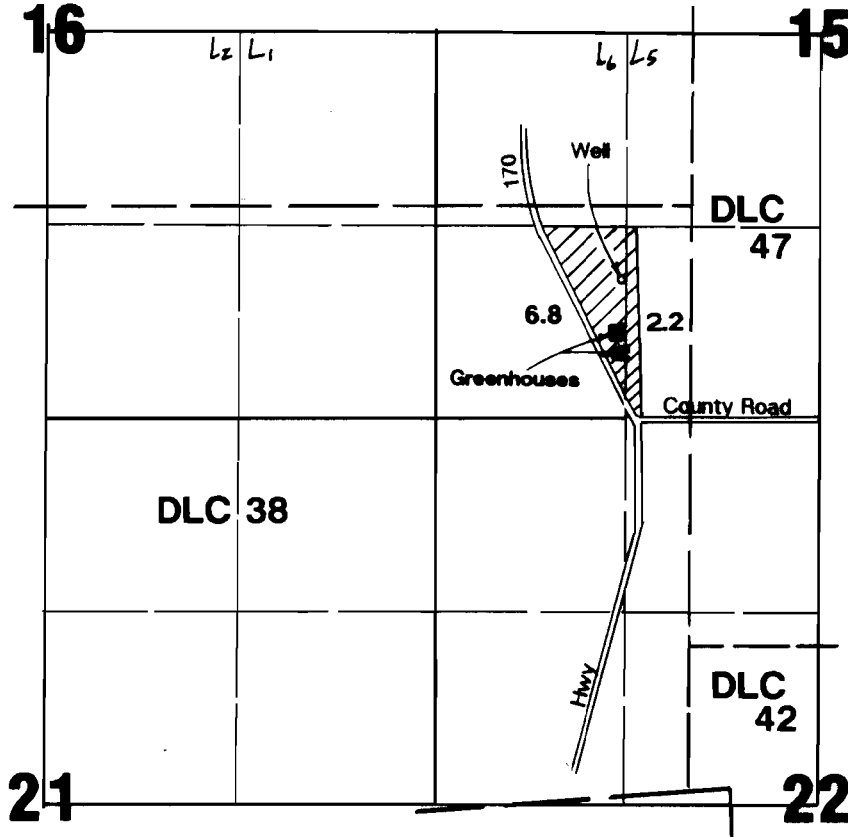

Well located 480'S & 470'W from NE corner DLC 38.

Final Proof Survey

Application #: G-12587 Permit #: G-11342

In Name Of

Richard Meek

Surveyed on September 6, 1995 by JM Schuette

THIS MAP WAS PREPARED FOR THE PURPOSE OF IDENTIFYING THE LOCATION OF A WATER RIGHT ONLY AND IS NOT INTENDED TO PROVIDE LEGAL DIMENSIONS OR LOCATION OF PROPERTY OWNERSHIP LINES.

