


T.23S.R.12W.W.M.

SECTION 20

NW1/4 SW1/4

SCALE 1" = 400'

WEST 1/4 COR.

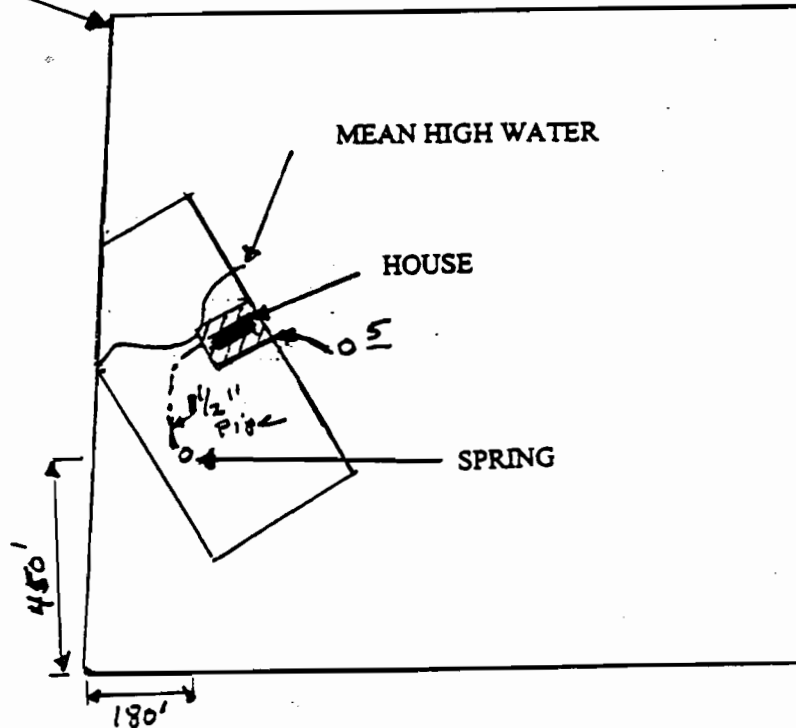

THE PURPOSE OF THIS MAP IS TO IDENTIFY THE LOCATION OF THE WATER RIGHT. IT IS NOT INTENDED TO PROVIDE INFORMATION RELATIVE TO THE LOCATION OF PROPERTY OWNERSHIP BOUNDARY LINES.



FINAL PROOF SURVEY
UNDER

Application No. 80651 Permit No. 52977

IN NAME OF

PAUL ORR AND BERNICE ORR

Surveyed MAY 17 1998 by DUANE KIRBY