



RECEIVED

SEP - 2 1997

WATER RESOURCES DEPT.
SALEM, OREGON

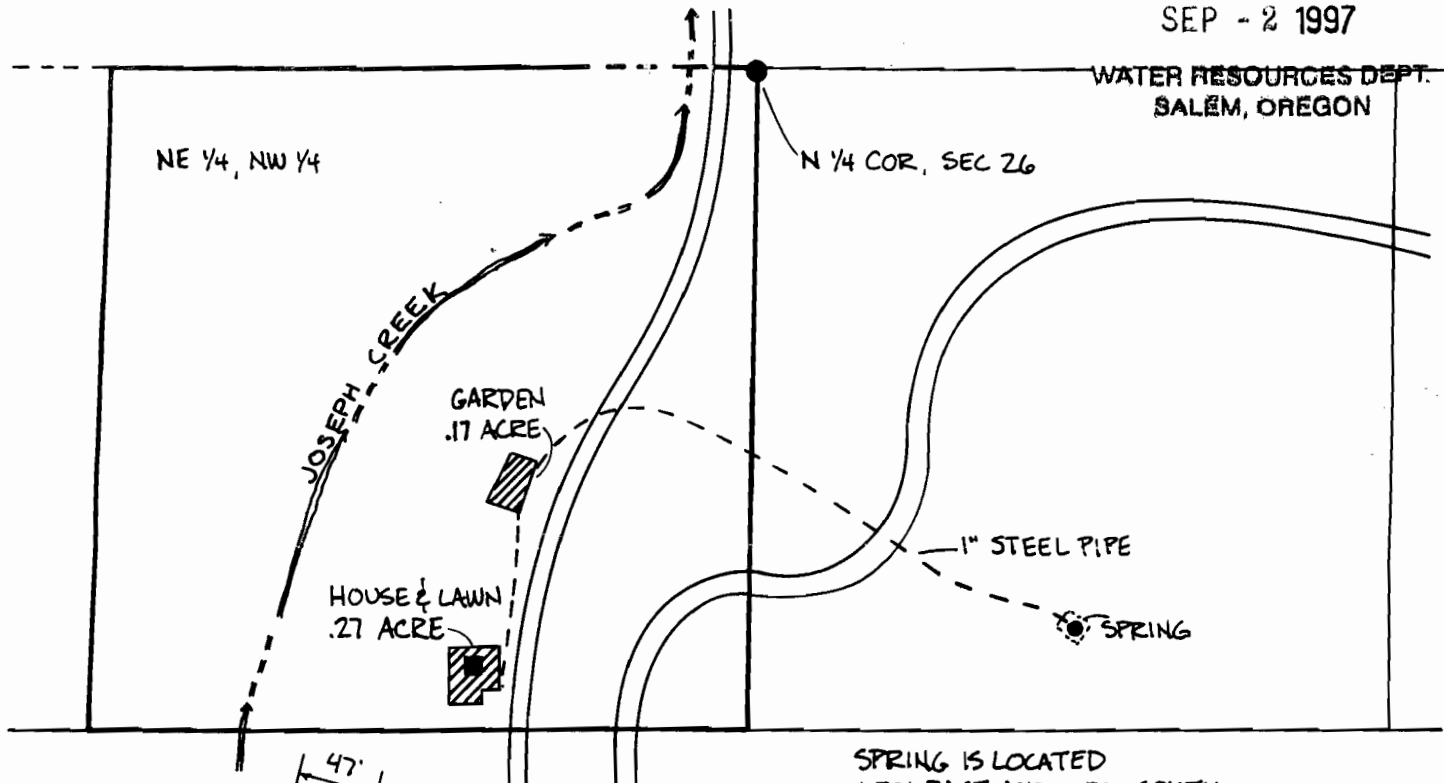


SPRING IS LOCATED
650' EAST AND 1150' SOUTH
OF THE NORTH 1/4 CORNER
OF SEC 26, T3N, R45E,
IN THE NW 1/4, NE 1/4, SEC 26.

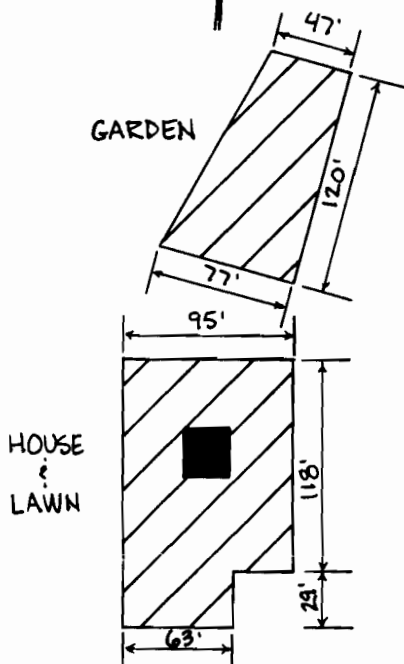

1" = 400'
SEC 26
T3N, R45E WM.

THIS MAP IS BASED ON ASCS
AERIAL PHOTOGRAPH AND FIELD
INVESTIGATION.

MAP IS PREPARED FOR WATER
RIGHT PURPOSES ONLY AND SHOULD NOT
BE USED FOR PROPERTY LOCATION.

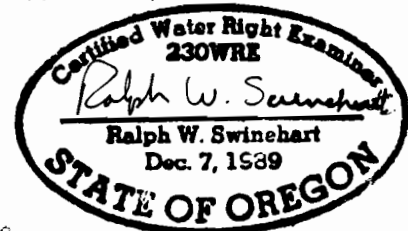

ORIGINAL - NO MYLAR

**DOMESTIC WATER RIGHT
FINAL PROOF MAP**

IN NE 1/4, NW 1/4, SEC 26, T3N, R45E, WM
PERMIT 52625 FOR: ED BUTLER WALLOWA COUNTY

DATE
9/97
JOB
DESIGN
RWS
DRAWN
TCB

WALLOWA MOUNTAIN
ENGINEERING
PO BOX 266
ENTERPRISE, OREGON 97828
426-4085

REVISIONS

SHEET
1 OF 1