

5/8" Iron Rod with plastic cap marked LS 1900 found.

Basis of Bearing

[N 88°28'32"W 412.50']

5/8" Iron Rod with plastic cap marked LS 1900 found.

RECEIVED

AUG 26 1998

WATER RESOURCES DEPT.
SALEM, OREGON

N 88°28'32"W 237.50'

N 88°28'32"W 412.50'

Point of Diversion
Concrete Reservoir and Pump House
Is N 19°34'48"W 1173.55'
From the Southeast corner of the
Hastings D.L.C. No. 42

Unnamed Creek

205 Feet of 1" P.V.C. Pipe
Supplied by a 1/2 H.P. Pump

RR Tie Posts

Point of use is
N 29°53'58"W 872.09'
From the Southeast corner
of the Hastings D.L.C. No. 42

Point of use is
N 12°12'22"W 959.92'
From the Southeast corner
of the Hastings D.L.C. No. 42

TRAILER

Richard L. and Loretta A. Rutt
Parcel 1, D.B. 214, Pg. 433

150 Feet of 3/4"
Plastic Pipe.

BARN

Point of use is
N 07°47'34"W 421.33'
From the Southeast corner
of the Hastings D.L.C. No. 42

880 Feet of 1-1/8" P.V.C. Pipe
Supplied by a 1 H.P. Pump

HOUSE

Richard L. and Loretta A. Rutt
Instrument No. 92-2297

South line of the Hastings D.L.C.

S 88°28'32"E 693.00'

East line of the Hastings D.L.C.

Richard L. and Loretta A. Rutt
Parcel 2, D.B. 214, Pg. 433

Southeast corner of the
Hastings D.L.C. No. 42

S 01°31'28"W 108.72'

S 88°28'32"E 418.65'

Legend


- Denotes monument found as noted
- Denotes calculated position
- [] Denotes record data per CS No. B-133

Note:

This map is for the purpose of identifying
the location of the water right only and is
not intended to provide legal dimensions or
location of property ownership lines.



Surveyed By
Dewey Surveying Inc.
County Courthouse
St. Helens, Oregon 97051
(503) 397-2316

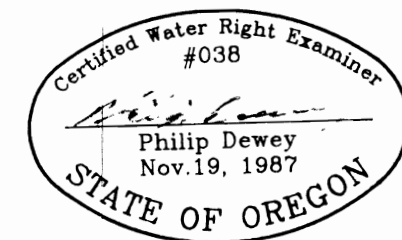

Renewal Date: 12-31-99

Water Right
Final Proof Survey
For
Richard L. Rutt
Application File Number: S-80441
Permit Number: 52731
in the Hastings D.L.C. No. 42
in the Northwest Quarter of
Section 16, T.7 N., R.4 W., W.M.
Columbia County, Oregon

February 4, 1998
Revised: August 21, 1998