

RECEIVED

CLAIM OF BENEFICIAL USE FINAL PROOF MAP

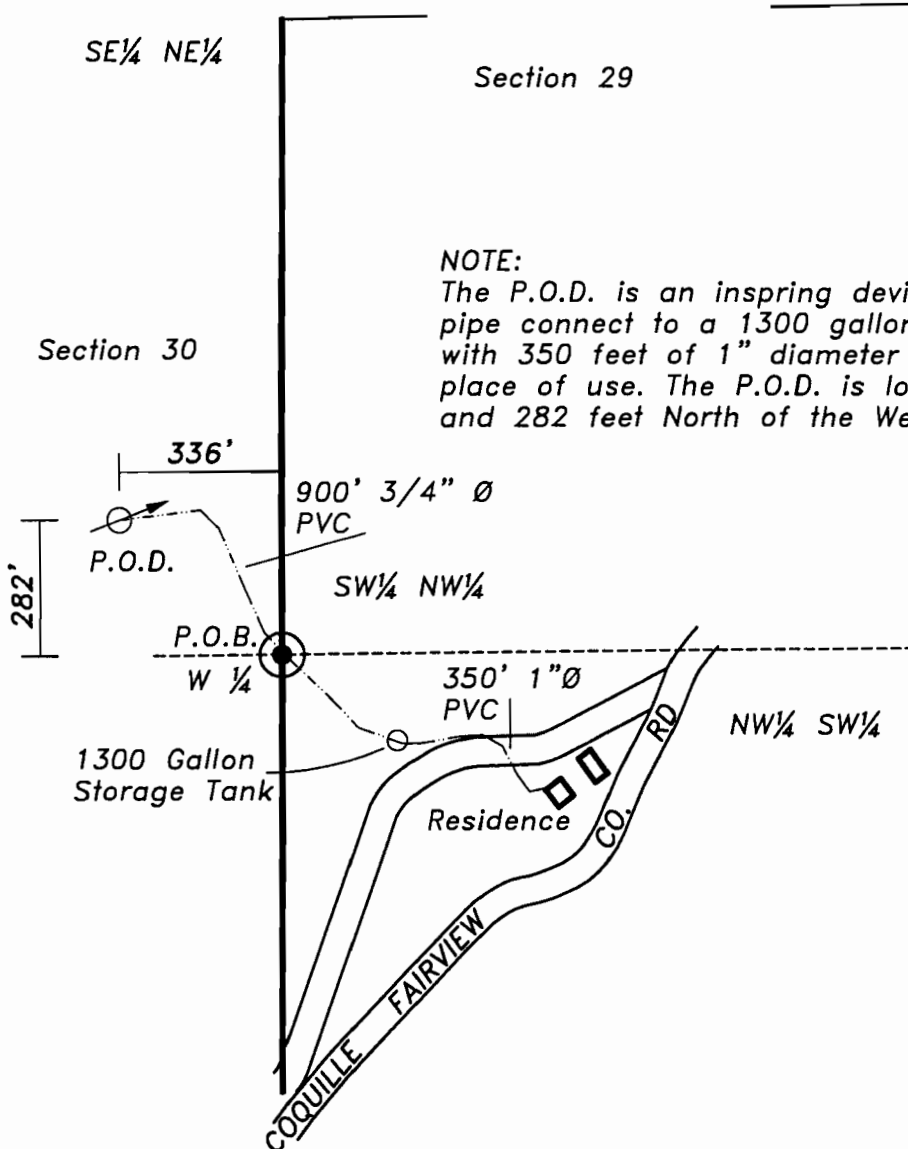
OCT 07 1999

WATER RESOURCES DEPT.
SALEM, OREGON**Legend**

- Pipe
- ⊗ P.O.D.
- RESIDENCE
- ⊙ P.O.B.

Located in the SE¼ NE¼ of Section 30
and in the NW¼ SW¼ of Section 29,
Township 27 South, Range 12 West, W.M.
Curry County, Oregon
Application # S-80383 Permit #52880

Scale 1" = 400 Feet

**NOTE:**

The P.O.D. is an inspring device. 900' of 3/4" PVC pipe connect to a 1300 gallon storage tank with 350 feet of 1" diameter PVC connecting to the place of use. The P.O.D. is located 336 feet West and 282 feet North of the West 1/4 corner of Section 29.



EXPIRES 06/30/00

Prepared For: George E. & Theresa L. MacQuarrie
Prepared By: Dennis Goude
Surveyed: September 27, 1999

**Stuntzner Engineering
& Forestry**

705 So. 4th Street
P.O. Box 118
Coos Bay, Oregon 97420

Phone (541) 267-2872
Fax (541) 267-0588

EXAMINERS DISCLAIMER STATEMENT

The preparation of this map was for the purpose of identifying the location of the Water Right only and has no intent to provide dimensions or location of property ownership lines.

99-277