



T1N, R10W, W.M.

THE PURPOSE OF THIS MAP IS TO IDENTIFY THE LOCATION OF THE WATER RIGHT. IT IS NOT INTENDED TO PROVIDE INFORMATION RELATIVE TO THE LOCATION OF PROPERTY OWNERSHIP BOUNDARY LINES.

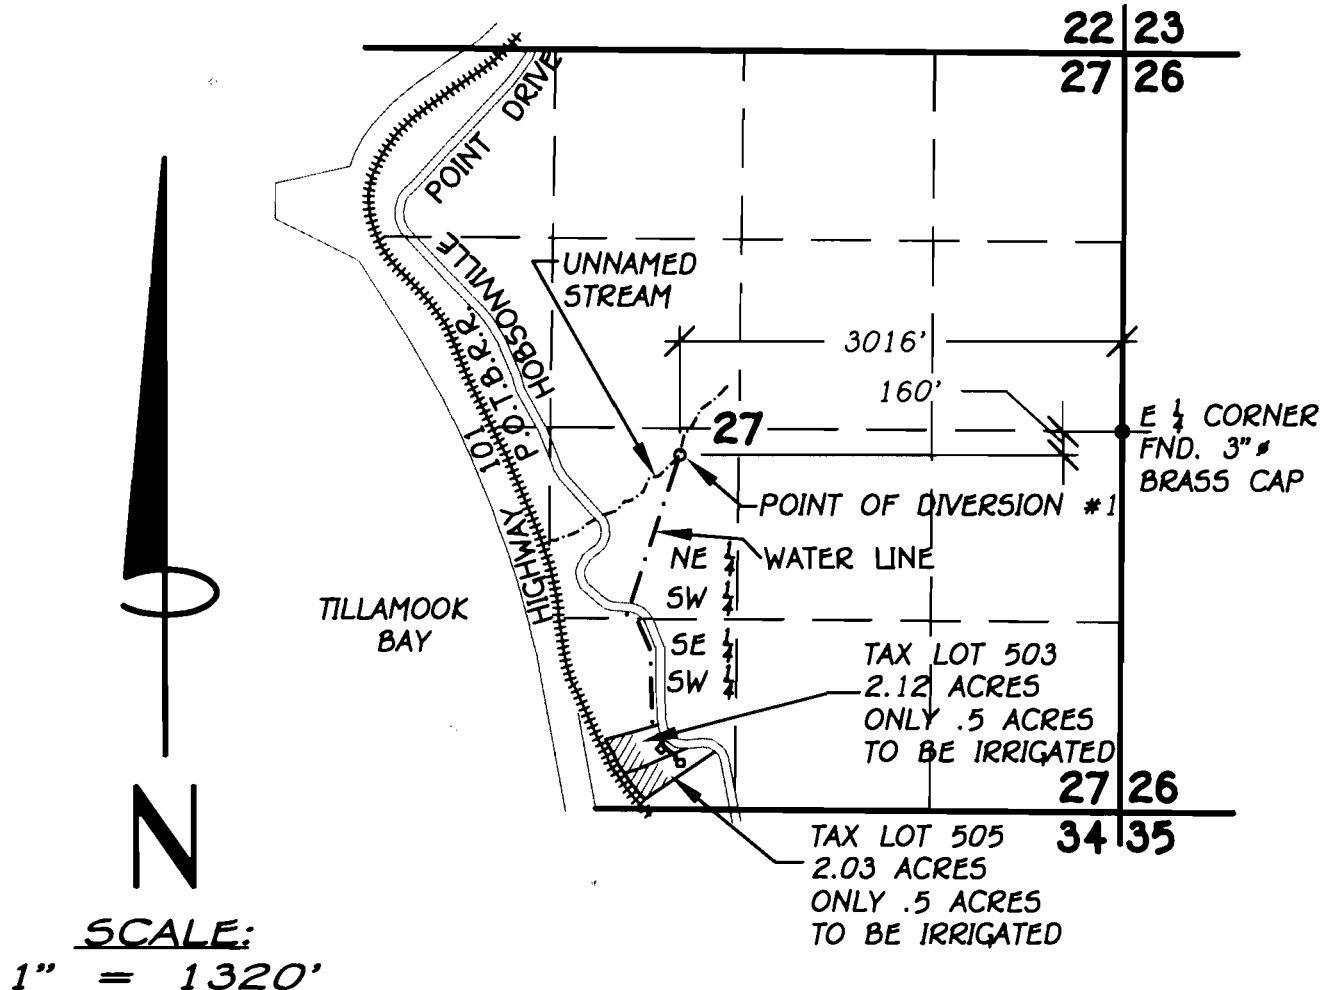

////// = AREAS TO BE IRRIGATED

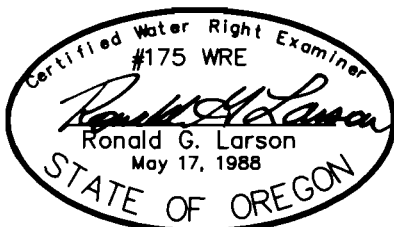

RENEWAL DATE: DECEMBER 31, 2006

**FINAL PROOF SURVEY
UNDER
APPLICATION 5-84629/PERMIT NO. 53736
IN THE NAME OF
SUSAN W. TOLLE
SEPTEMBER 9, 2005**

M050202-01-01.DWG