


T10S, R10W, W.M.

RECEIVED SE 1/4 - NW 1/4, SECTION 27
AUG 25 1998 LINCOLN COUNTY, OREGON




SCALE 1 inch = 400 feet

RESOURCES DEPT.
SALEM, OREGON

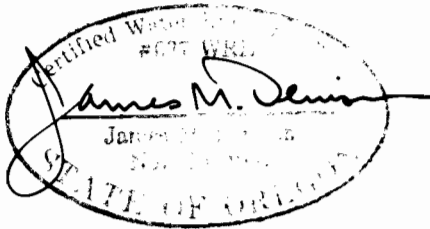

SE 1/4 - NW 1/4

POINT OF DIVERSION
146.3' NORTH AND
712.2' WEST OF C 1/4
SECTION 27

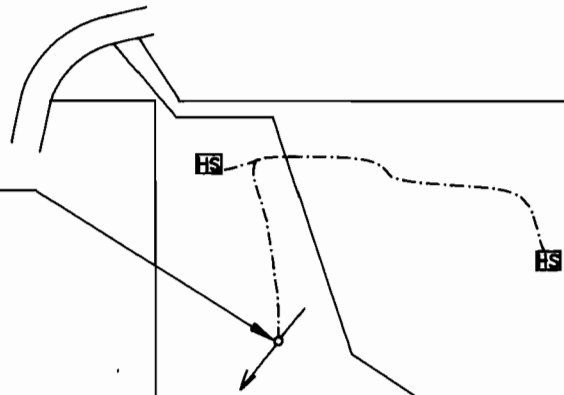

CENTER 1/4
SEC. 27

FINAL PROOF SURVEY UNDER

APPLICATION • S-77866

PERMIT • 52598

IN THE NAME OF
CHARLES AND DEANNA COOK

SURVEYED: OCTOBER 21, 1997

BY: J. M. DENISON

THIS MAP PREPARED SOLEY FOR THE PURPOSE OF SHOWING LOCATION OF A WATER RIGHT, AND IS NOT INTENDED FOR USE TO PROVIDE DIMENSIONS OR LOCATION OF PROPERTY OWNERSHIP LINES