


CLAIM OF BENEFICIAL USE FINAL PROOF MAP

Located in portions of the NW¼ SW¼ & NE¼ SW¼ of Section 24,
Township 28 South, Range 14 West, Willamette Meridian
Coos County, Oregon
Permit #52678

RECEIVED
JUN 21 1999
WATER RESOURCES DEPT.
SALEM, OREGON

Prepared For: Jim Berry
Prepared By: Dennis Goude
Prepared: June 8, 1999

NOTE:
The P.O.D. is an instream screened
75-gallon barrel. The P.O.D. is located
1950 feet East and 1900 feet North of
the Southwest corner of Section 24,
Township 28 South, Range 14 West, W.M.

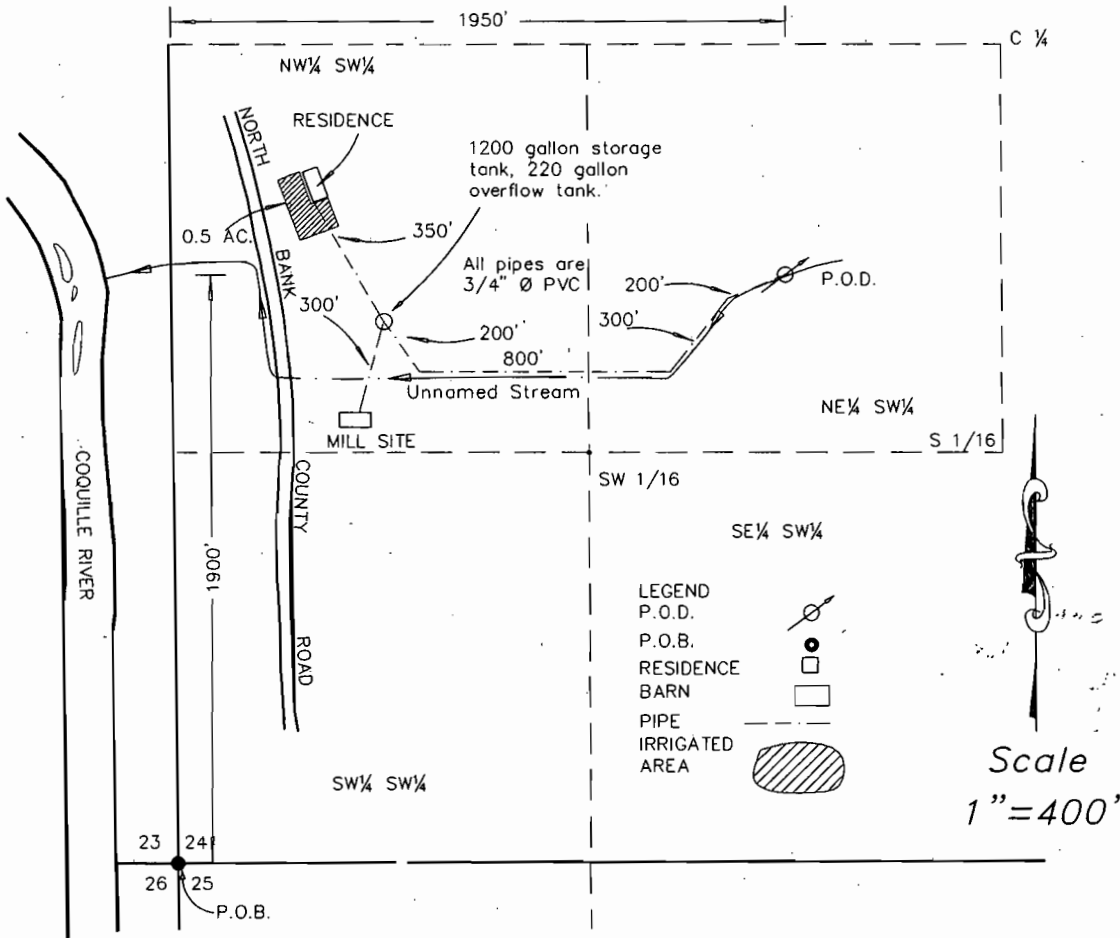

EXPIRES 06/30/99

**Stuntzner Engineering
& Forestry, L.L.C.**

ENGINEERING • LAND SURVEYING • FORESTRY
PLANNING • WATER RIGHTS

705 South 4th St.
Post Office Box 118
Coos Bay, Oregon 97420
Phone: (541) 867-8672
Fax: (541) 867-0688

Drawn By: Dennis Goude Date: June 7, 1999

Checked By: Tom Hoshall Drawing No.: 85-299JB

Designed By: Andrew

App. Name: Berry Final Proof Sheet 1 of 1

EXAMINER'S DISCLAIMER STATEMENT

The preparation of this map was for the purpose of
identifying the location of the Water Right only and
has no intent to provide dimensions or location of
property ownership lines.

RECEIVED
JUN 21 1999
WATER RESOURCES DEPT.
SALEM, OREGON