

GORDON HOWARD

T.18S., R.12W., W.M.

SECTION 1

FINAL PROOF MAP

APPLICATION NO. S-83372

PERMIT NO. S-53512

TAX LOT 800

MAP NO. 18-12-1

REVISED TO: 18-12-01-43 TL100


LANE COUNTY, OREGON

OCTOBER 4, 1999

RECEIVED

NOV 04 1999



WATER RESOURCES DEPT.
SALEM, OREGON

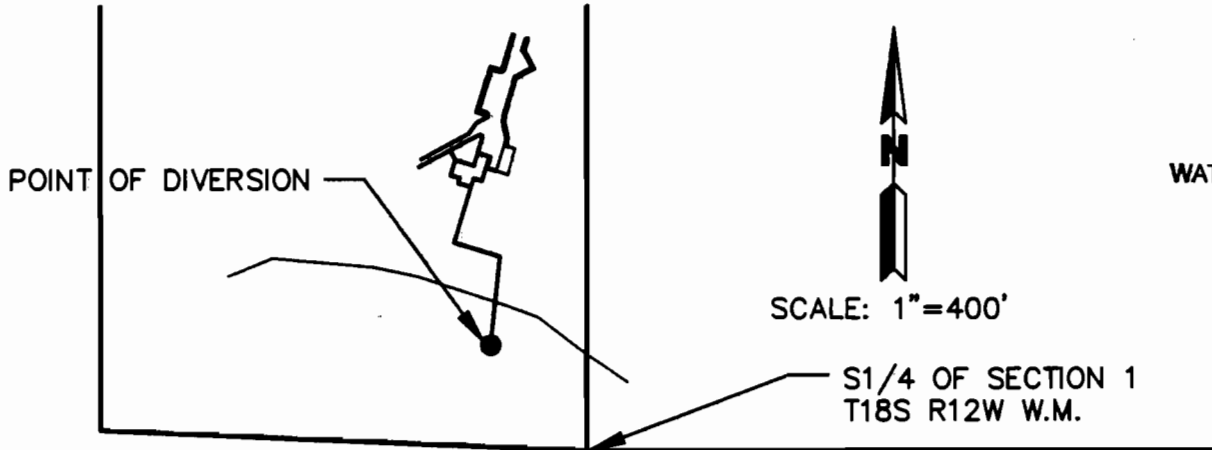

VICINITY MAP

POINT OF DIVERSION

PUMP IS 220 FEET NORTH & 200
FEET WEST OF THE SOUTH 1/4
CORNER OF SECTION 1.

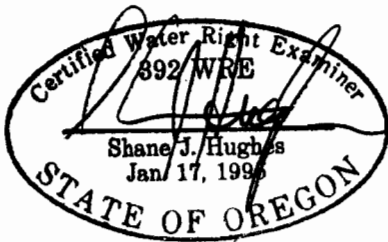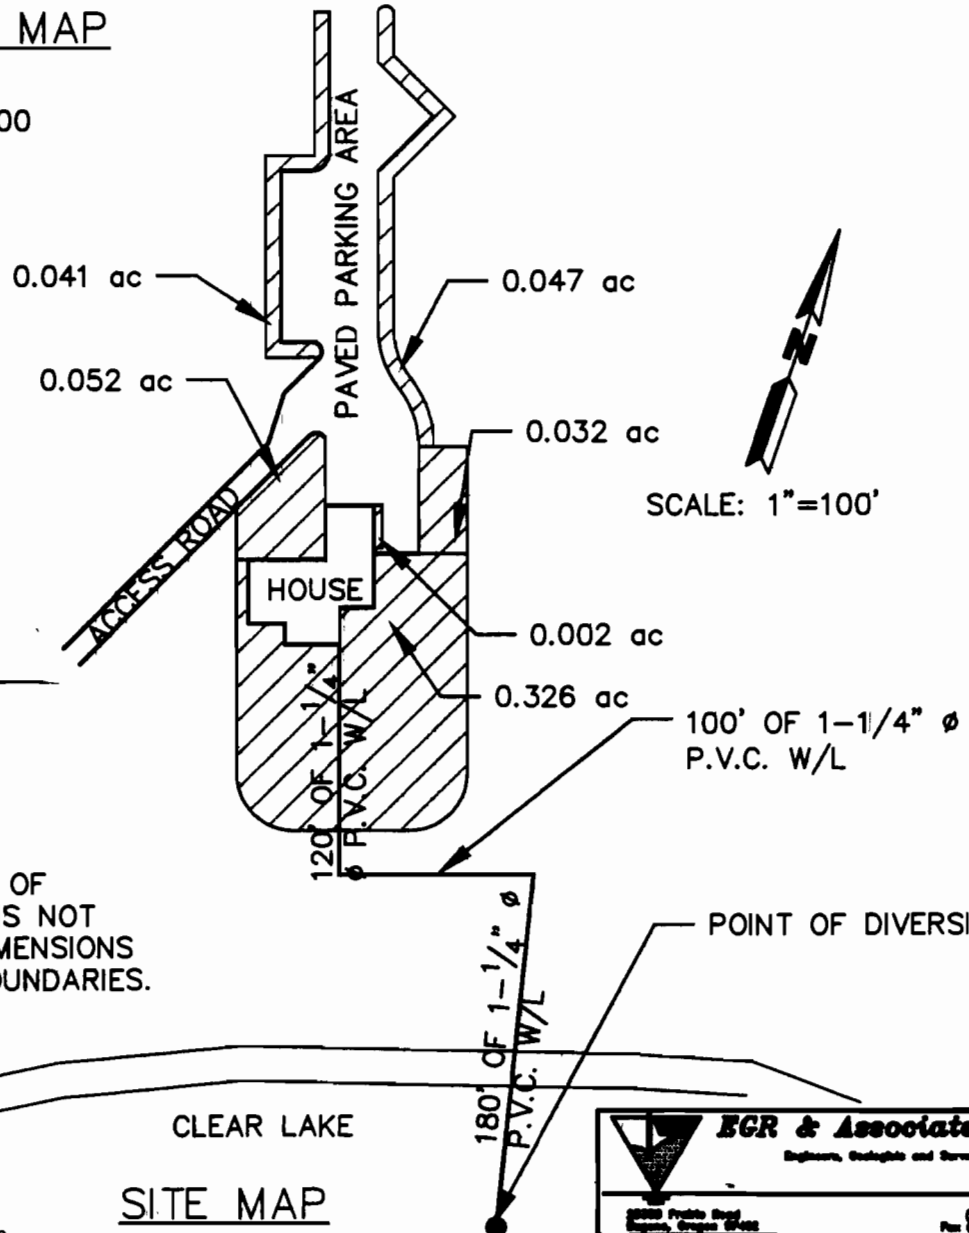

THIS MAP IS FOR THE PURPOSE OF
LOCATING A WATER RIGHT AND IS NOT
INTENDED TO PROVIDE LEGAL DIMENSIONS
FOR LOCATION OF PROPERTY BOUNDARIES.