


RECEIVED

MAR 09 1999

WATER RESOURCES DEPT.
SALEM, OREGON

T15S, R12W
SE1/4-SW1/4 SECTION 27
LANE, COUNTY, OREGON

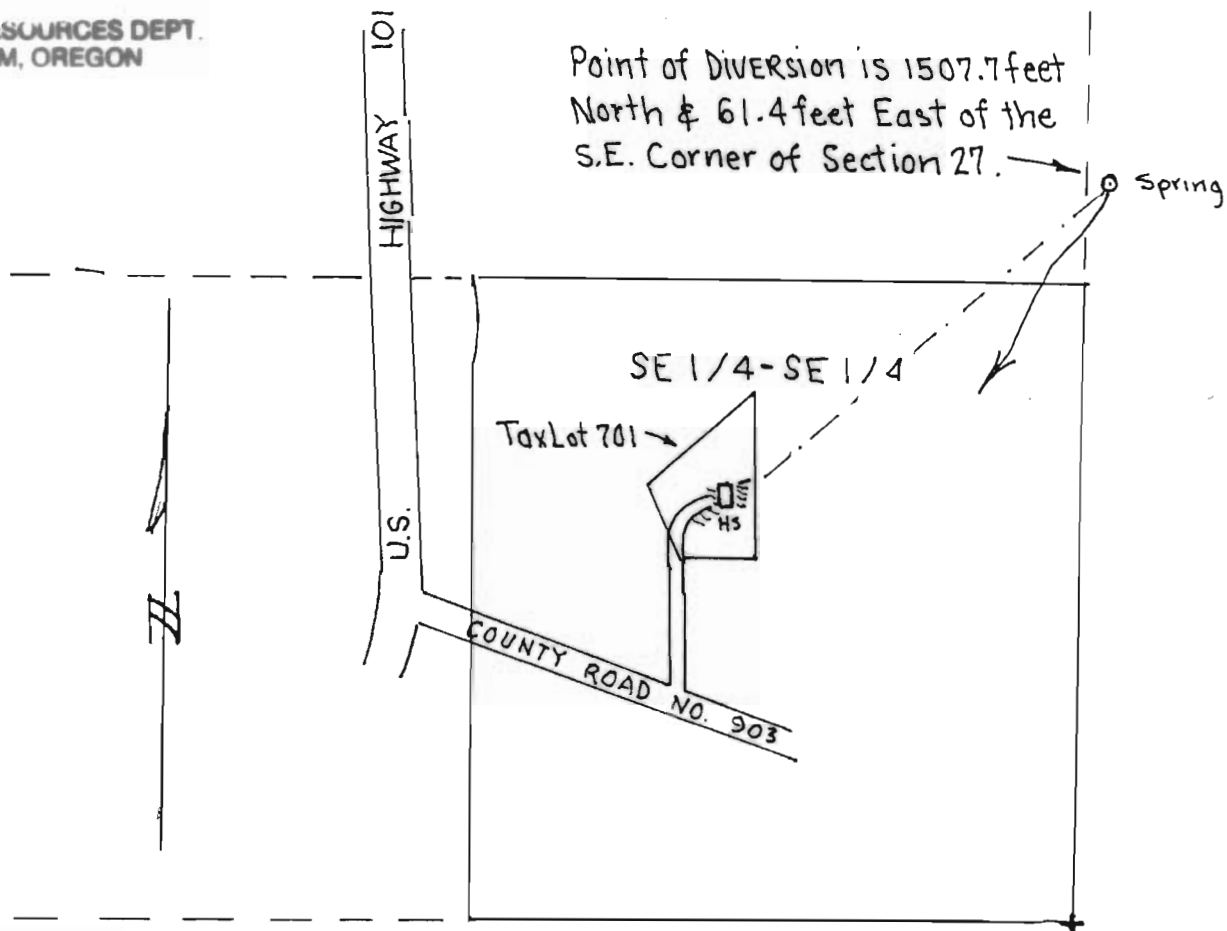

FINAL PROOF SURVEY
UNDER

Scale : 1 inch = 400 feet

APPLICATION # S.-81006

PERMIT # 53192

IN THE NAME OF

Thomas Nesbit & Sarah Cantril

Surveyed: February 15, 1999

BY: J. M. Denison

THIS MAP PREPARED SOLEY FOR THE PURPOSE OF SHOWING LOCATATION OF A WATER
RIGHT, AND IS NOT INTENDED FOR USE FOR PROVIDE DIMENSIONS OR LOCATION OF
PROPERTY OWNERSHIP

