


T. 20S., R.12 W., W.M.

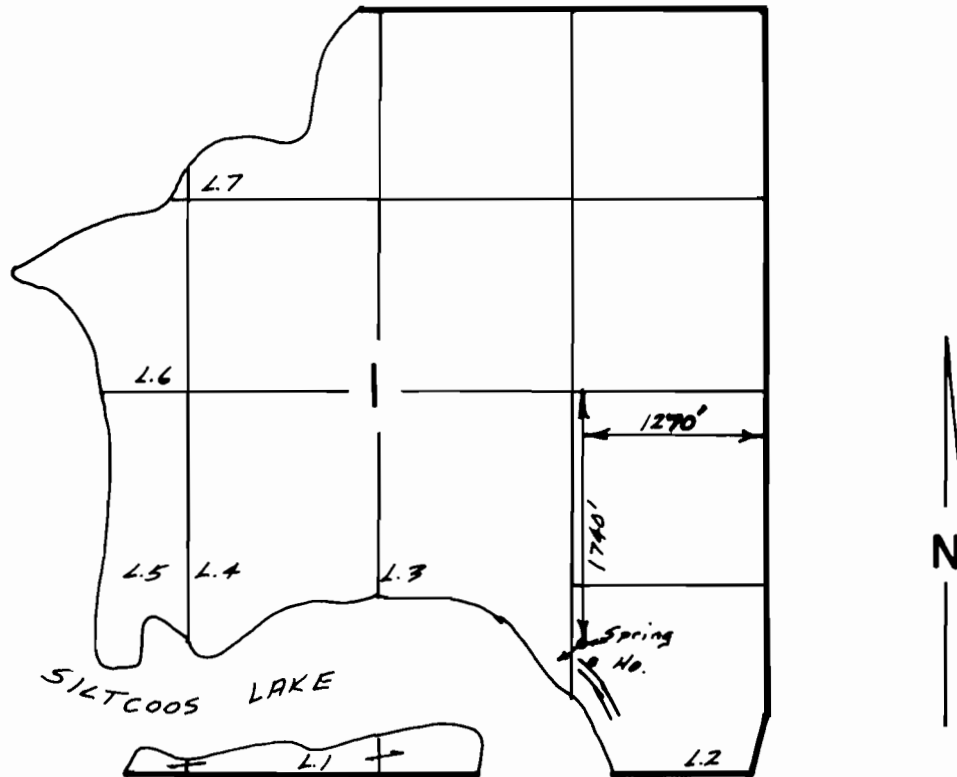

Scale 1" = 1320'

**FINAL PROOF SURVEY
UNDER**

Application No. 61075. Permit No. 46122....
IN NAME OF

BOBBY J. & DORIS A. GARRETT

Surveyed Sept. 26, 1994, by B.S. DeHaas....