
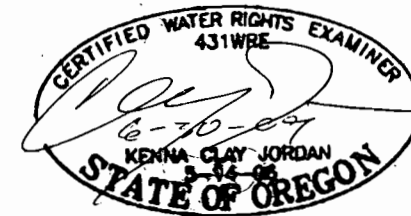
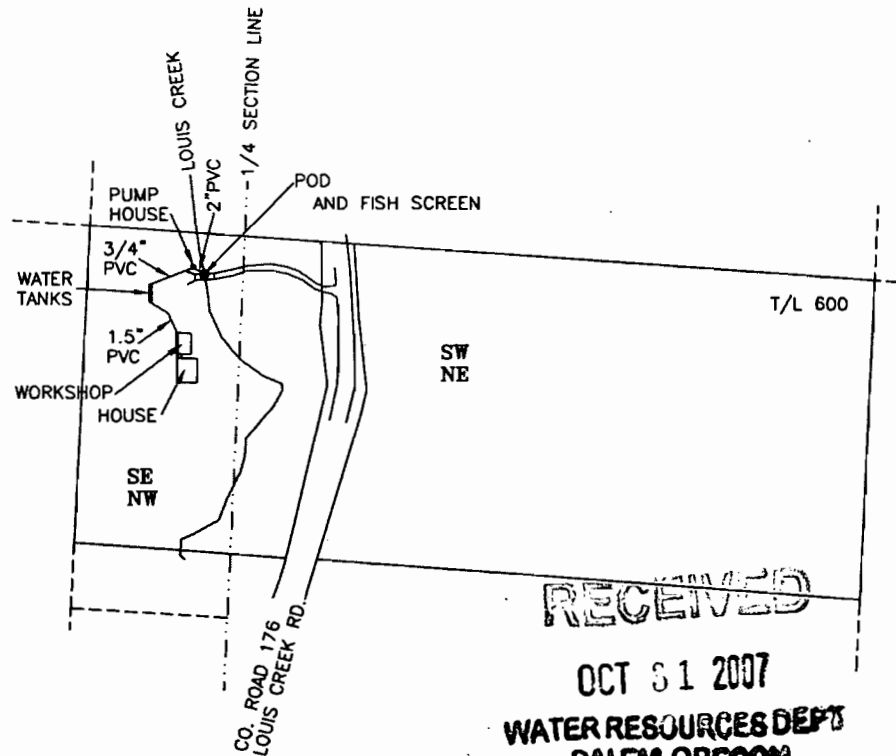


CLAIM OF BENEFICIAL USE MAP

IN THE NAME OF
HENRY J AND LUPE A MCDERMOTT

SE 1/4 NW 1/4 SECTION 14
TOWNSHIP 29 SOUTH, RANGE 4 WEST, W.M.
TAX LOT 600
DOMESTIC USE EXPANDED

APPLICATION S-84672
PERMIT S-53769
SOURCE OF WATER: LOUIS CREEK

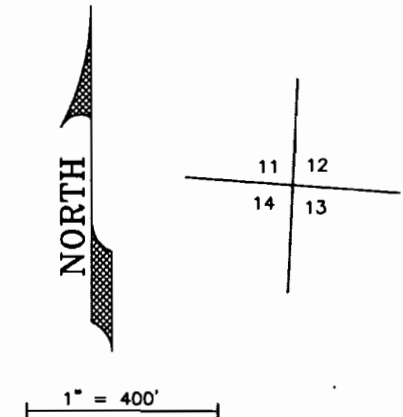

POD IS LOCATED 1386 FEET SOUTH 2715 FEET WEST FROM
THE NORTHEAST CORNER OF SECTION 14; BEING WITHIN
THE SW 1/4 NE 1/4 OF SECTION 14, TOWNSHIP 29, SOUTH,
RANGE 4 WEST, W.M. DOUGLAS COUNTY.

LOCATIONS PER 1/4 1/4 ARE DERIVED BY ASSUMED FIT
OF AERIAL PHOTO ORIENTATION TO GROUND SURVEYS
AND/OR TAX ASSESSOR MAPS.

THE PURPOSE OF THIS MAP IS TO IDENTIFY THE LOCATION OF THE WATER RIGHT.
IT IS NOT INTENDED TO PROVIDE INFORMATION RELATIVE TO THE LOCATION OF
PROPERTY OWNERSHIP BOUNDARY LINES.

RECEIVED
OCT 31 2007
WATER RESOURCES DEPT
SALEM, OREGON

JORDAN ENGINEERING
460 JORDAN LANE
ROSEBURG, OR 97470
(541) 673-1931

101007