


SECTION 9, TWP.2 N. RANGE 16 E. W.M.
 SHERMAN COUNTY, OREGON

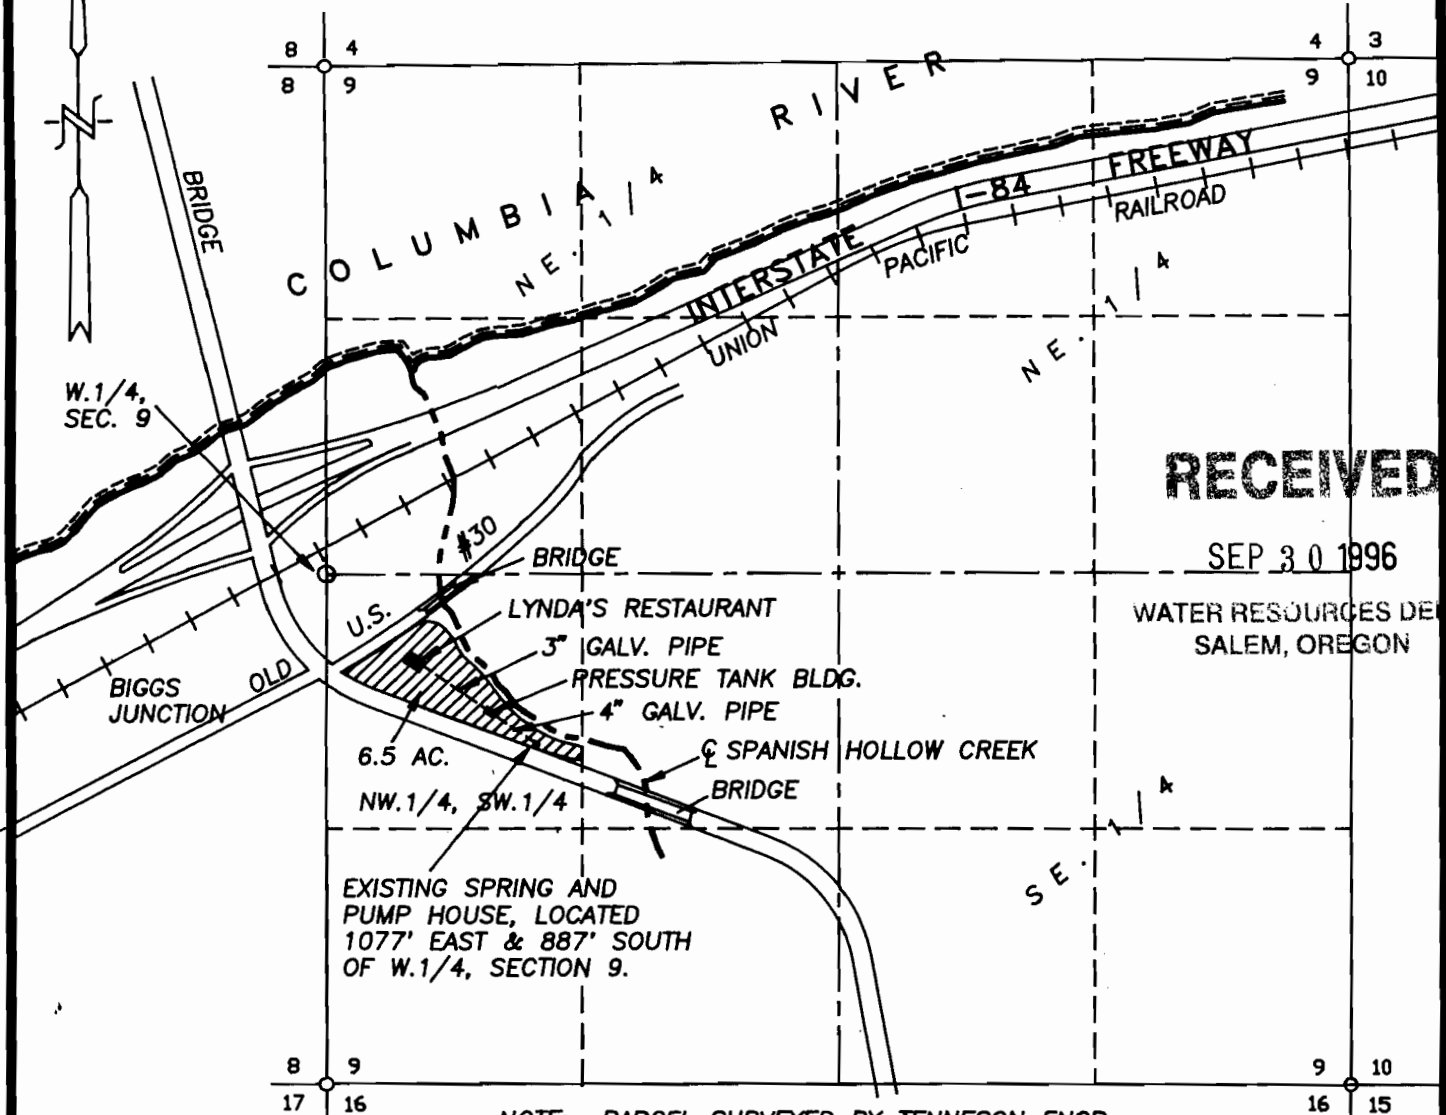

RECEIVED

SEP 30 1996

WATER RESOURCES DEPT.
 SALEM, OREGON

WATER RIGHT
FINAL PROOF SURVEY

SCALE: 1" = 1000'


CERTIFICATE No. _____

PERMIT No. 51377

IN THE NAME OF:
WILLIAM AND LINDA BEERS

DATE: SEPTEMBER 27, 1996

BY: TENNESON ENGINEERING CORP.
 409 LINCOLN STREET,
 THE DALLES, OREGON. 97058
 PH. 541-296-9177
 FAX 541-296-6657

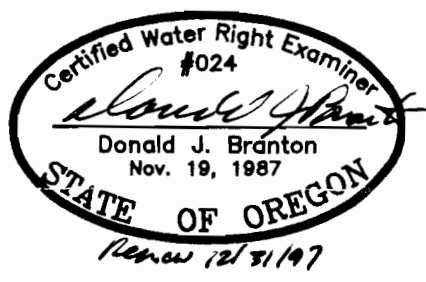

NOTE:
 "THIS MAP IDENTIFIES THE LOCATION OF THE WATER RIGHT ONLY AND IS NOT INTENDED TO PROVIDE DIMENSIONS OR LOCATE PROPERTY OWNERSHIP LINES."

W.O. #7287