



T13S, R11W, W.M.
SW 1/4 - NE 1/4 SECTION 18
LINCOLN COUNTY, OREGON

SCALE 1 inch = 400 feet

E 1/16 Sec 18

N 1/4

RECEIVED

JAN 26 1998


WATER RESOURCES DEPT
SALEM, OREGON

SW 1/4-NE 1/4

POINT OF DIVERSION #2
S7°12'W, 1882.4' FROM
EAST 1/16 COR. ON NORTH
LINE SEC. 18

POINT OF DIVERSION #1
S2°34'W, 2432.1' FROM
EAST 1/16 COR. ON NORTH
LINE SEC. 18

James M. Denison

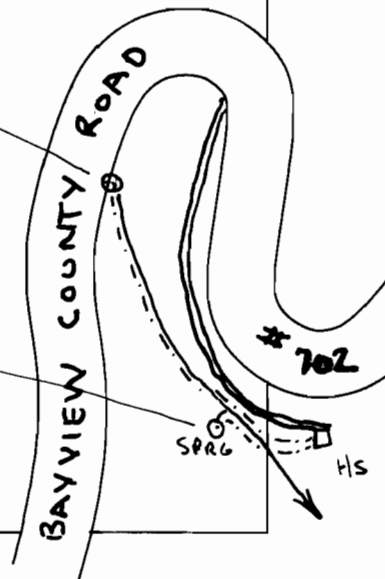

C 1/4

FINAL PROOF SURVEY UNDER

APPLICATION # S-74463

PERMIT # 52523

IN THE NAME OF
HARRY W. & JEAN T. HUMASON

SURVEYED: AUGUST 13, 1997

BY: J. M. DENISON

THIS MAP PREPARED SOLEY FOR THE PURPOSE OF SHOWING LOCATION OF A WATER RIGHT, AND
IS NOT INTENDED FOR USE TO PROVIDE DIMENSIONS OR LOCATION OF PROPERTY OWNERSHIP LINES