



T.26S., R.4W., W.M.

SECTION 17

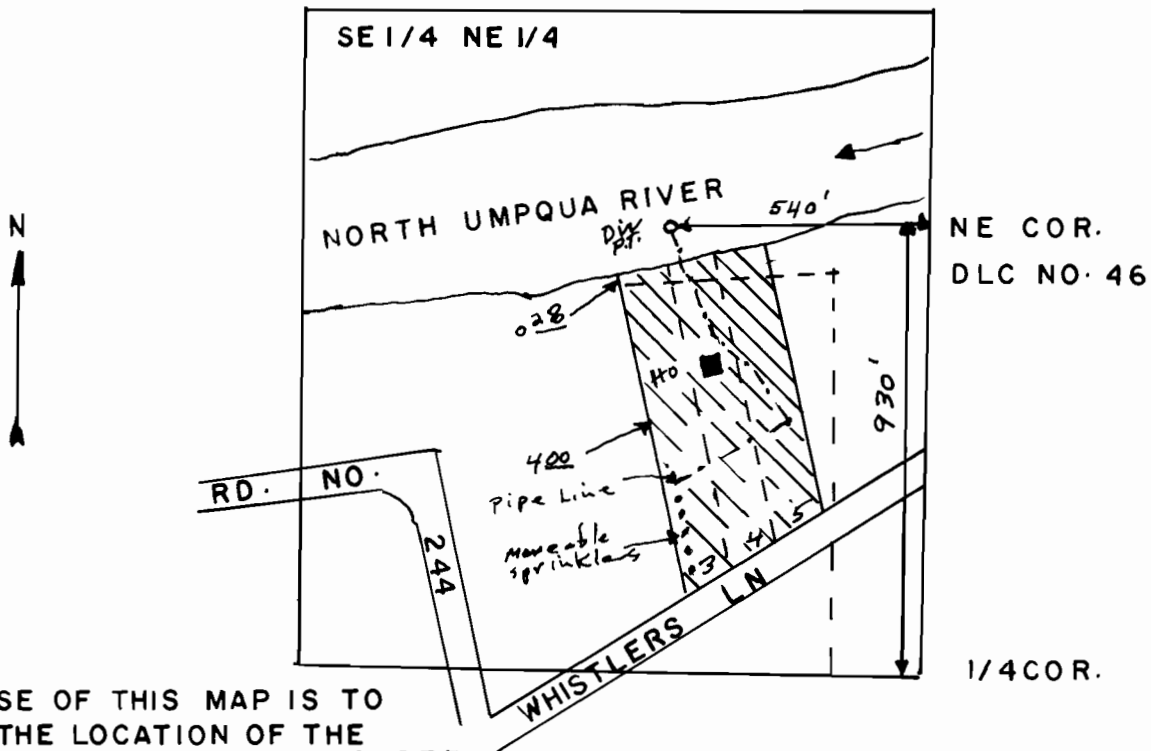

THE PURPOSE OF THIS MAP IS TO IDENTIFY THE LOCATION OF THE WATER RIGHT. IT IS NOT INTENDED TO PROVIDE INFORMATION RELATIVE TO THE LOCATION OF PROPERTY OWNERSHIP BOUNDARY LINES. SCALE 1" = 400'

FINAL PROOF SURVEY
UNDER

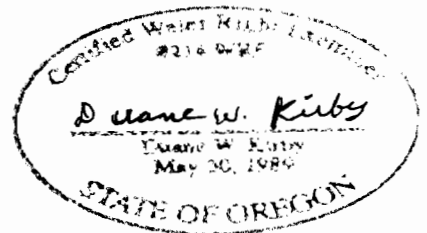

Application No. 70965 Permit No. 51266
IN NAME OF
THORVALD S. CHELLSTORP
SARAH A. CHELLSTORP

Surveyed Sept 25, 1993 by DUANE KIRBY