


T. 6 S., R. 1 E., W.M.

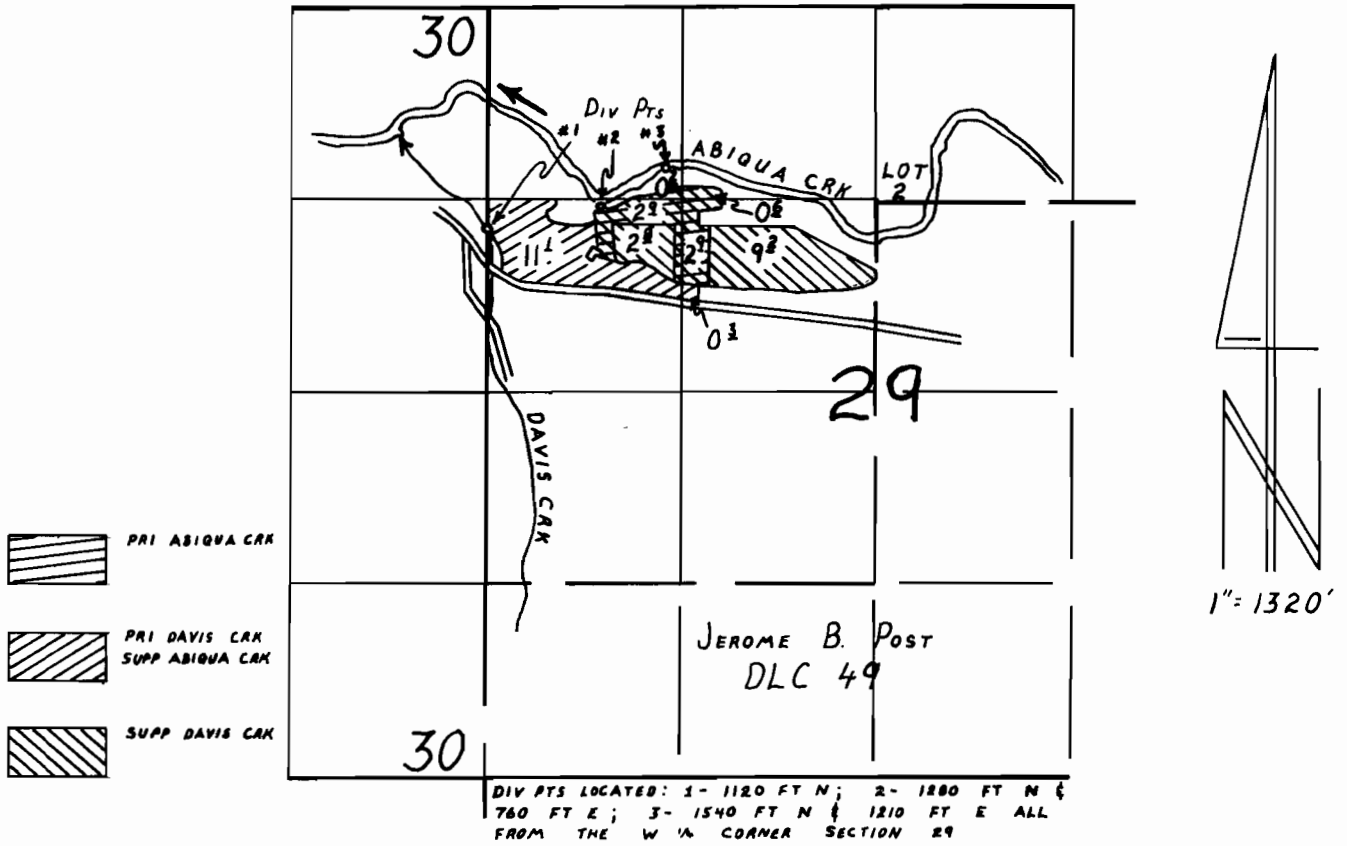

FINAL PROOF SURVEY

UNDER

Application No. 69106 Permit No. 50011

IN NAME OF

RICK ROLIE

Surveyed AUGUST 13, 1992, by R.W. Klassen