



T 22 S, R 32 E, WM

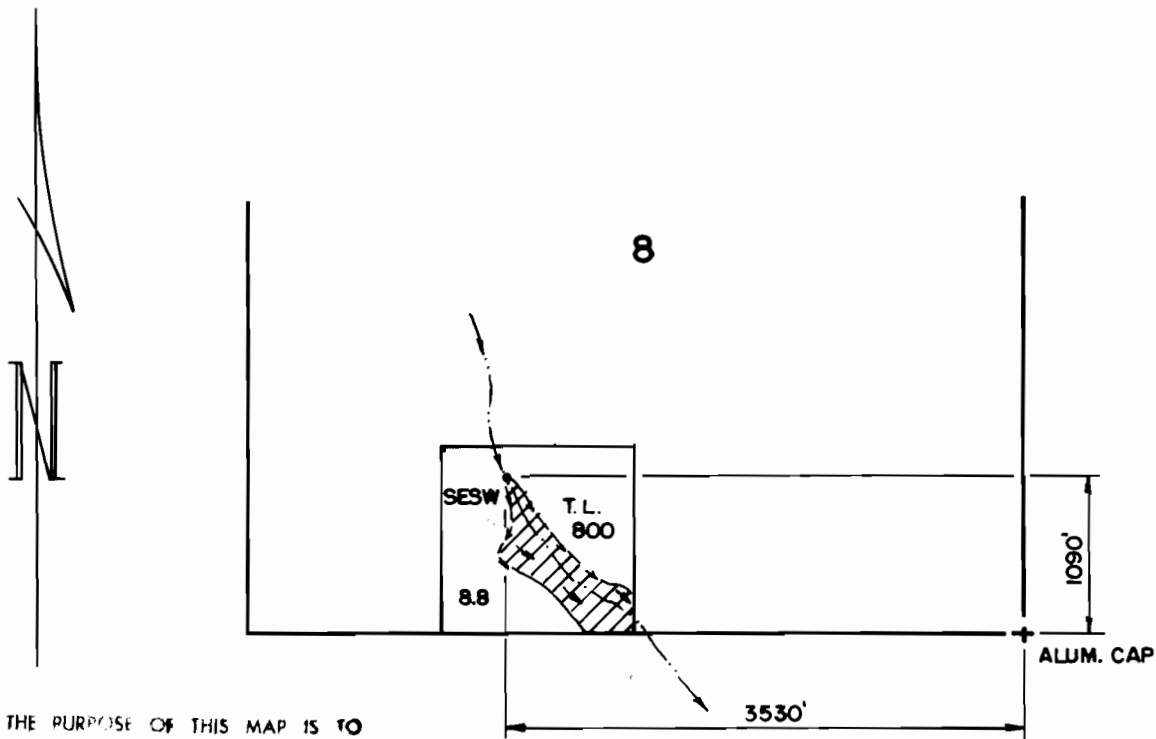

THE PURPOSE OF THIS MAP IS TO IDENTIFY THE LOCATION OF THE WATER RIGHT. IT IS NOT INTENDED TO PROVIDE INFORMATION RELATIVE TO THE LOCATION OF PROPERTY OWNERSHIP.

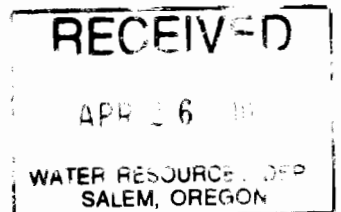

FINAL PROOF SURVEY

UNDER
APPLICATION NO. S-83441
PERMIT NO. 53386

IN THE NAME OF
JOSEPH R. & ROBERTA
L. OLTMAN

Scale: 4" = 1 MILE

Date: APR. 2002

Job: 1675-02

Dsn:

Dm: CHRIS

Ckd:



M.A. PALMER & SONS, INC.
ENGINEERING & SURVEYING
711 Ponderosa Village • Box 61
Burns, Oregon 97720

Sgt. No.

of 1

RENEW 1-1-2003