


CLAIM OF BENEFICIAL USE
SURVEYED MAY 25, 2000
BY DUANE KIRBY
FOR DANIEL S. QUINN

T 26 S., R 4 W. W.M.
SECTION 13
SCALE 1" = 400'
Application no. 70319
Permit no. 52292

C 1/4
Section 13

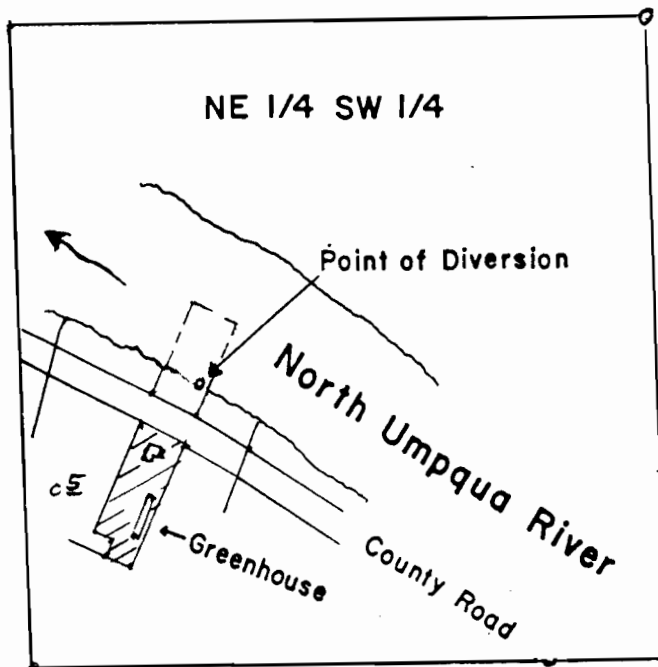

P.O.D. is 740 ft. South and
960 ft. West of the C 1/4
Section 13.

THE PURPOSE OF THIS MAP IS TO
IDENTIFY THE LOCATION OF THE
WATER RIGHT. IT IS NOT INTENDED
TO PROVIDE INFORMATION RELATIVE
TO THE LOCATION OF PROPERTY
OWNERSHIP BOUNDARY LINES.

RECEIVED

JUN 08 2000

WATER RESOURCES DEPT.
SALEM, OREGON

