

T30S, R2W, WM


SCALE 1" = 1320'

DOUGLAS COUNTY

RECEIVED

AUG 16 1999

WATER RESOURCES DEPT.
SALEM, OREGON

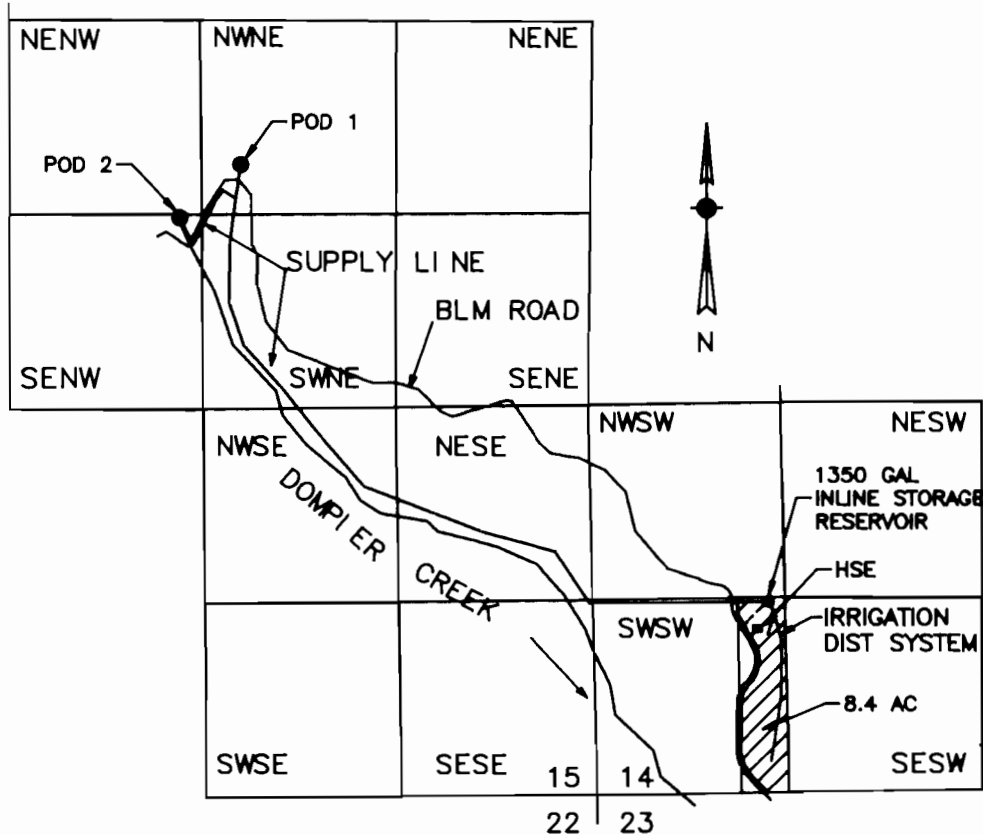

POD 1 IS 4340 FT N AND 2440 FT W FROM SW COR SECTION 14
POD 2 IS 4070 FT N AND 2870 FT W FROM SW COR SECTION 14

FINAL PROOF SURVEY UNDER

Application No. S-70533 Permit No. 51723

IN NAME OF

STEVEN EVERIDGE OR JERI KEATLEY

Surveyed May 19, 1999 by M E Farr

THIS IS A LOCATION MAP FOR A FINAL PROOF SURVEY BY STEVEN EVERIDGE OR JERI KEATLEY. THIS MAP IS FOR THE PURPOSE OF IDENTIFYING THE LOCATION OF THE WATER RIGHT ONLY AND IS NOT INTENDED TO PROVIDE LEGAL DIMENSIONS OR LOCATION OF PROPERTY OWNERSHIP LINES.

