
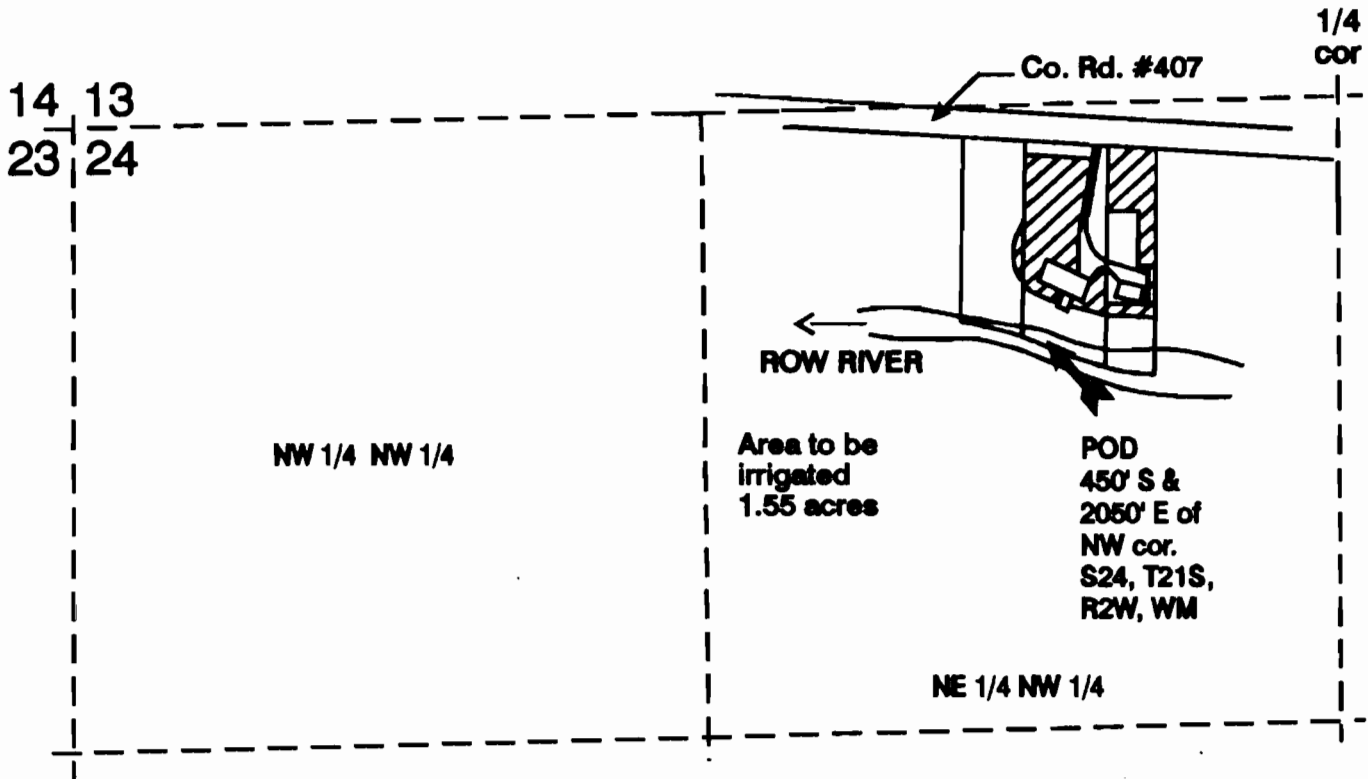


NE 1/4 NW 1/4 S24, T21S, R2W, W.M.

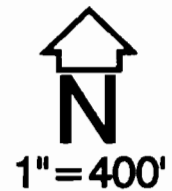

final proof survey map
MARC OR KAREN BOYD

Application 71478

Permit 51635

This map is for water resources use only
and does not provide information relative
to the location of property boundaries.

RECEIVED

JUN 17 1996

WATER RESOURCES DEPT.
SALEM, OREGON

