


T26S.R6W.W.M.

1 INCH = 1320 FEET

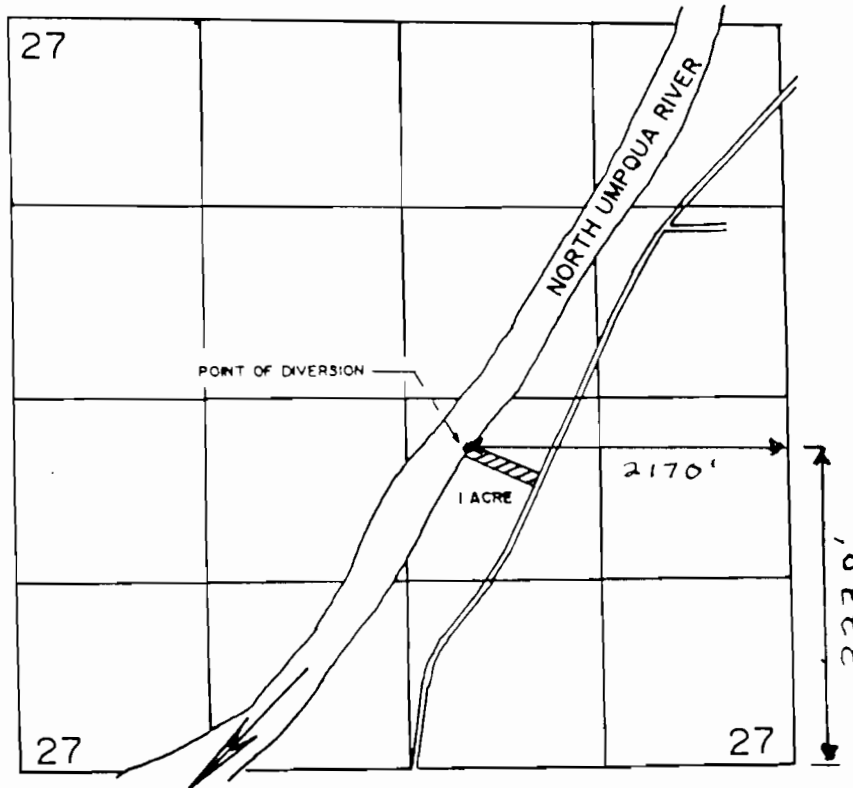

THE PURPOSE OF THIS MAP IS TO IDENTIFY THE LOCATION OF THE WATER RIGHT. IT IS NOT INTENDED TO PROVIDE INFORMATION RELATIVE TO THE LOCATION OF PROPERTY OWNERSHIP BOUNDARY LINES.



FINAL PROOF SURVEY UNDER

Application No. 70365 Permit No. 51675

IN NAME OF

JENNIFER L. DOERNER AND MICHAEL A. STEVENSON

Surveyed DEC 9 1998 by DUANE KIRBY