


CLAIM OF BENEFICIAL USE
FOR DANA ERICKSON
BY DUANE KIRBY
DATE 7/09/03
T22S, R10W, WM
SECTION 14
PERMIT NO 53822

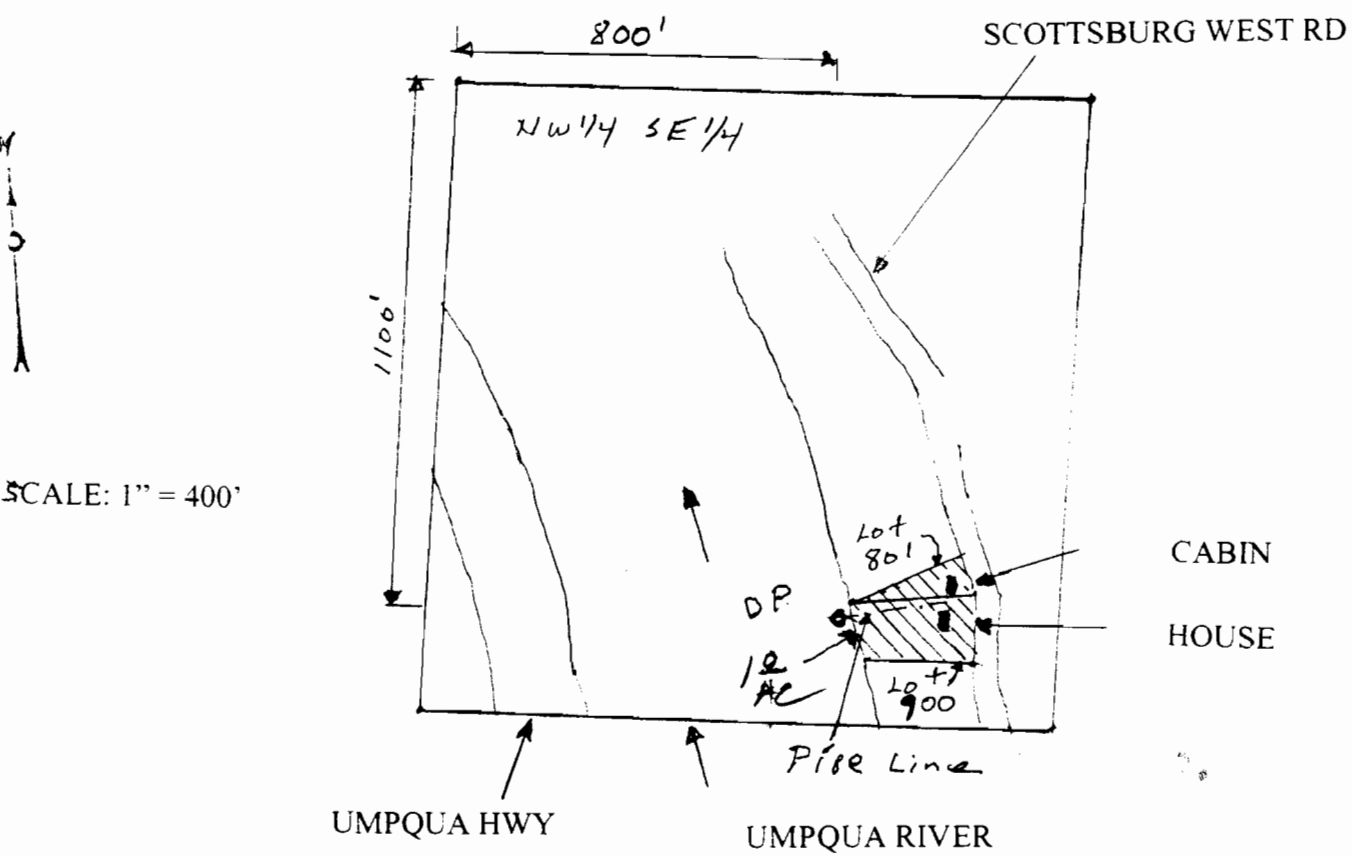

THE PURPOSE OF THIS MAP IS TO IDENTIFY THE LOCATION OF THE WATER RIGHT. IT IS NOT INTENDED TO PROVIDE INFORMATION RELATIVE TO THE LOCATION OF PROPERTY OWNERSHIP BOUNDARY LINES.

