


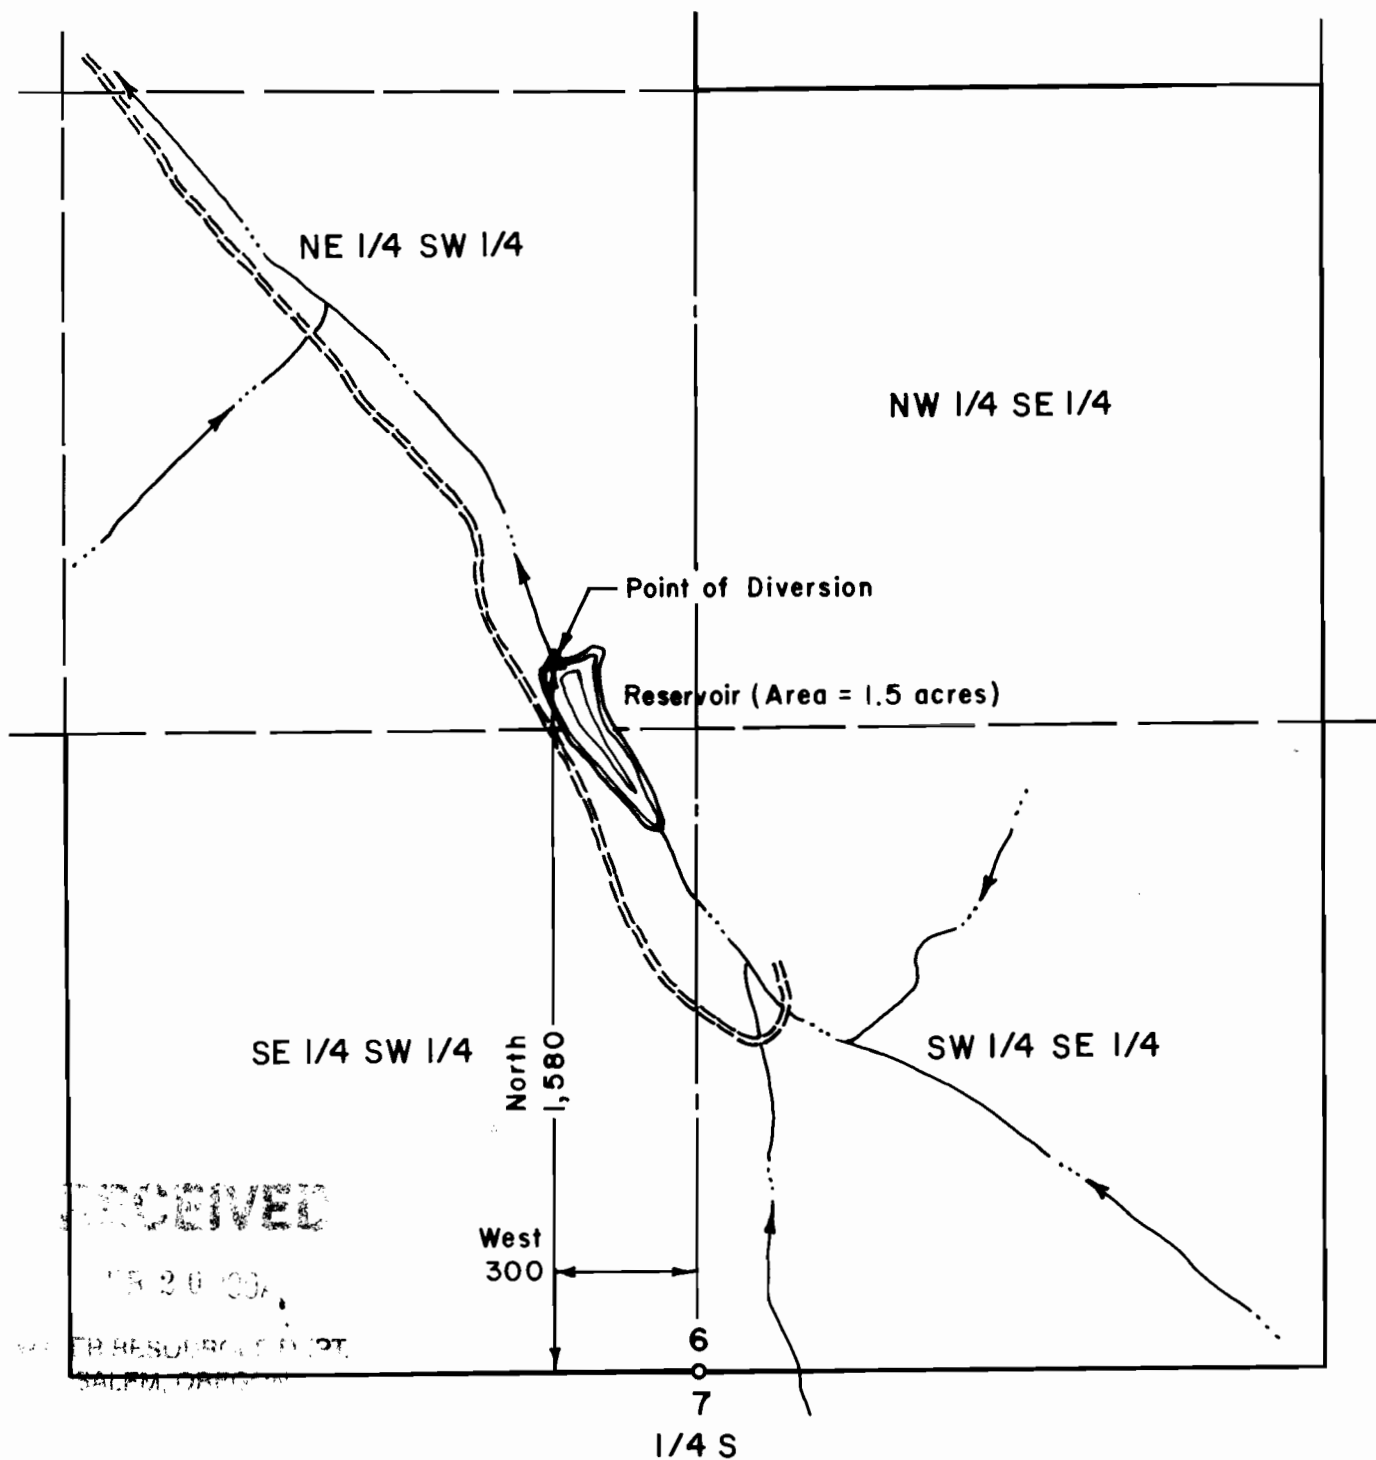

Scale: 1" = 400 ft.



FINAL PROOF SURVEY OF A
RESERVOIR APPLICATION PERMIT
in the S 1/2 of Section 6, T 27 S,
R 3 W, W. M., Douglas County, Oregon
Application No. R-71434
Permit No. R-11589

For: Harry D. Young
3247 Wild River Drive
Roseburg, Oregon 97470

By: Shaner Engineering, Inc.
P. O. Box 1430
Roseburg, Oregon 97470

January 30, 1997