

28 27 TOWNSHIP 16 SOUTH, RANGE 2 EAST, WM

33 34

RECEIVED

MAY 11 2004

WATER RESOURCES DIV.
SALEM, OREGON

NW 1/4
NW 1/4

NE 1/4
NW 1/4

McKENZIE

POINT OF
DIVERSION

BURIED
PIPE

RIVER

3.27 AC

SE 1/4
NW 1/4

SW 1/4
NW 1/4

NICHOLS
ROAD



SCALE

1" = 400'


MAY 2, 2004

APPLICATION #S71308, PERMIT S51760


POINT OF DIVERSION LOCATION:
1452.5 FEET SOUTH & 1921.6 FEET
EAST OF NORTHWEST CORNER
SECTION 34.

LEGEND

• DENOTES PERMANENT SPRINKLER HEAD LOCATION

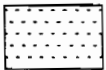

DENOTES AREA OF BENEFICIAL WATER USE

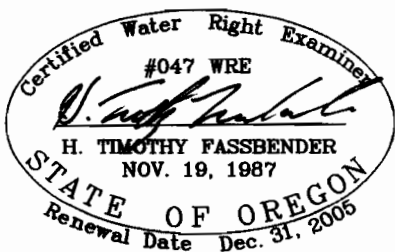

NOTE

THIS MAP WAS PREPARED FOR THE PURPOSE OF IDENTIFYING
THE LOCATION OF THE WATER RIGHT ONLY. IT IS NOT INTENDED

FINAL PROOF SURVEY

FOR

RICK McCREERY

45951 GOODPASTURE

VIDA, OREGON 97488

PH 541-896-3220

BY

H. TIMOTHY FASSBENDER

2896 SARAH LANE

EUGENE, OREGON 97408

541-485-3136