


CLAIM OF BENEFICIAL USE
 FOR: AARON KENTON, ROAL KENTON,
 ROGER KENTON, AND APRIL SETTELL
 T 23S, R10W, W.M.
 SECTION 25
 APPLICATION NO. 72262
 PERMIT NO 53215
 TAX LOT NO 100

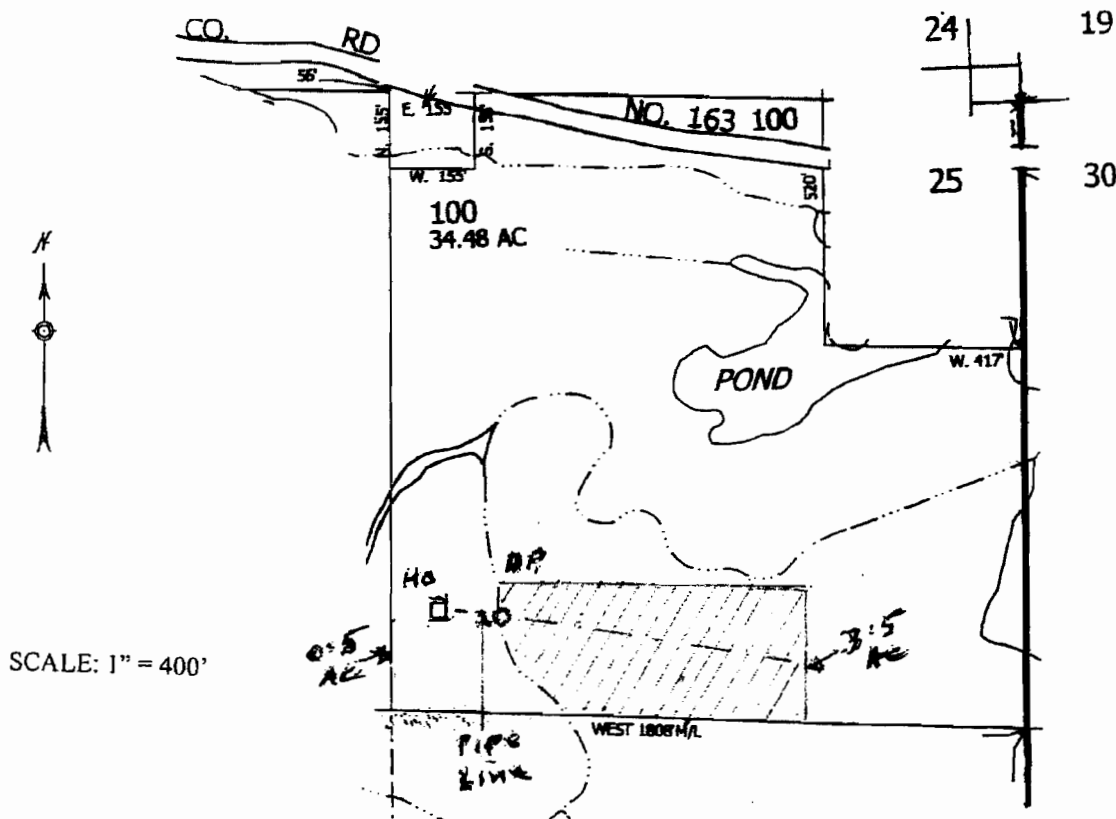

POINT OF DIVERSION LOCATION: NE 1/4 NE 1/4, SECTION 25, TOWNSHIP 23 SOUTH,
 RANGE 10 WEST, W.M.; POD 1 - 1120 FEET SOUTH & 1100 FEET WEST FROM THE
 NORTHEAST CORNER, SECTION 25.

NOTE: FISH SCREEN IS AT THE DIV. PT.

RECEIVED

AUG 22 2007

WATER RESOURCES DEPT
 SALEM OREGON

THE PURPOSE OF THIS MAP IS TO
 IDENTIFY THE LOCATION OF THE
 WATER RIGHT. IT IS NOT INTENDED
 TO PROVIDE INFORMATION RELATIVE
 TO THE LOCATION OF PROPERTY
 OWNERSHIP BOUNDARY LINES.

