
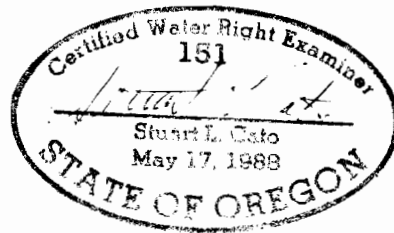


SE 1/4, SE 1/4, SEC.12, T. 1N, R5E, W.M.

1 INCH = 400 FEET

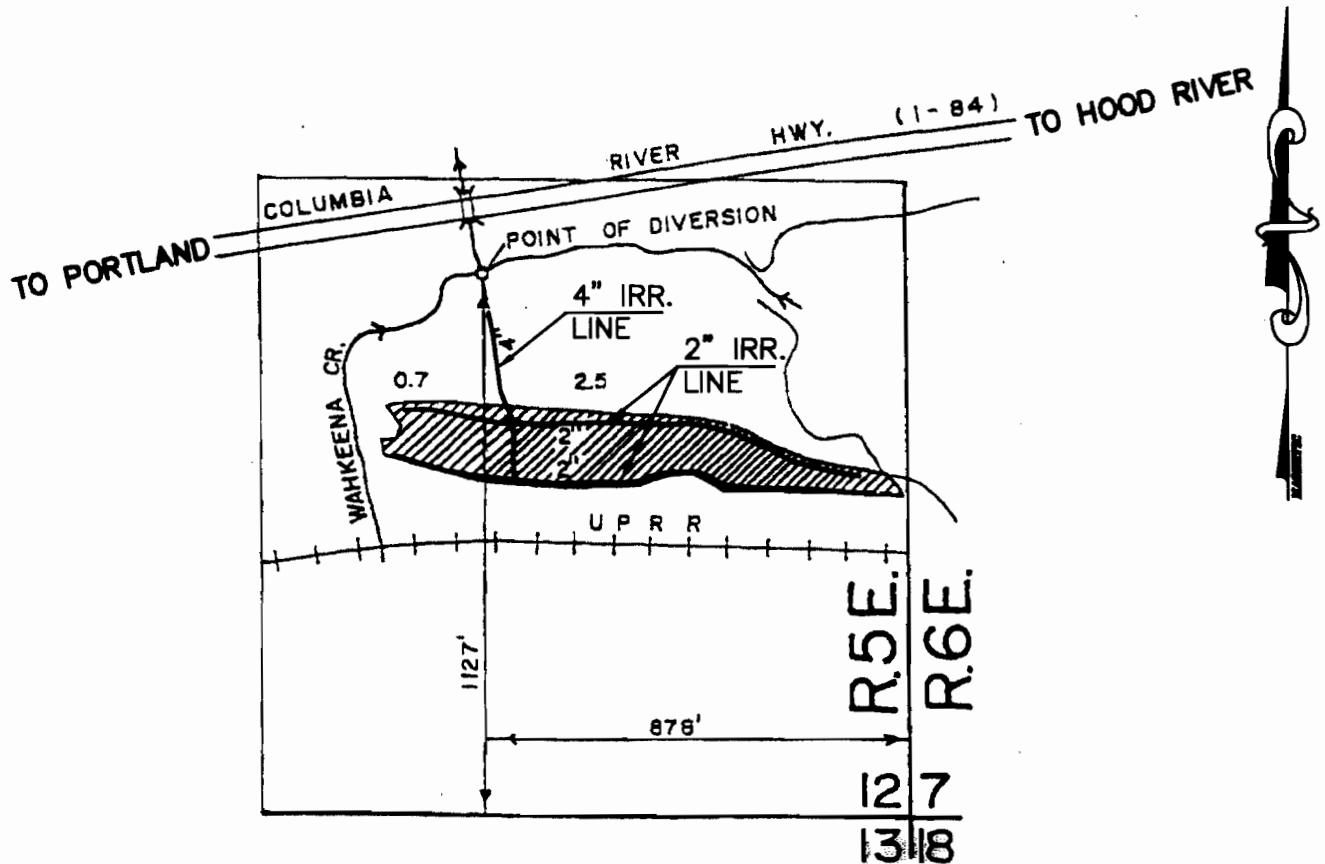


RECEIVED

NOV 17 1998

WATER RESOURCES DEPT
SALEM, OREGON

FINAL PROOF SURVEY
UNDER
APPLICATION NO. S-73010 PERMIT NO. 52153
IN THE NAME OF
OREGON PARKS AND REC. DEPT.
BENSON STATE PARK

 <p>Consulting Engineers 111 S.W. Fifth Avenue Suite 2500 Portland, Oregon 97204 503-227-3251</p>	TITLE:	DATE:
	<p>OREGON STATE PARKS DEPT. BENSON STATE PARK WATER RIGHTS</p>	<p>10/16/98</p>
	<p>1115 COMMERCIAL NE SALEM, OR 97301 (503)378-6305</p>	<p>DWG. NO. 98155-1</p>