


RECEIVED


SEP 24 1998

WATER RESOURCES DEPT.  
SALEM, OREGON

TOWNSHIP 18 SOUTH, RANGE 3 WEST, W.M.

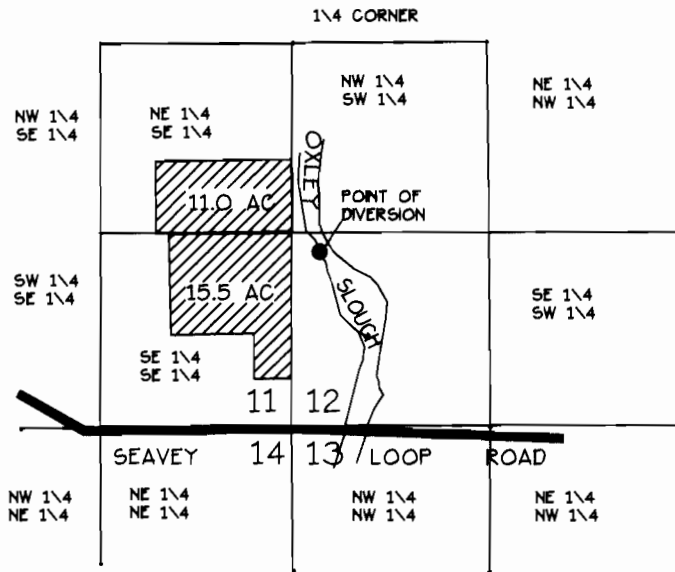

POINT OF DIVERSION:  
1227.80' NORTH +  
237.65' EAST FROM THE  
S.W. CORNER SECTION 12.

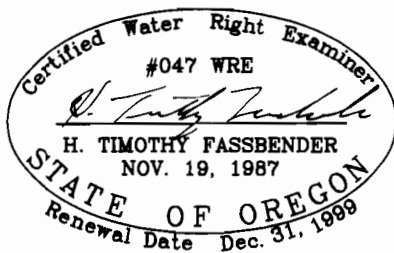

FINAL PROOF SURVEY  
APPLICATION THIS PERMIT 81870

FOR  
CHARLES SCOTT MOORE & MARY EYONUK MOORE  
34137 SEAVEY LOOP  
EUGENE, OR 97405  
PH(541)741-4790

BY  
FORD-NEBB-FASSBENDER, INC.  
PO BOX 22735  
EUGENE, OR 97402  
PH(541)344-1852  
SEPTEMBER 16, 1988

NOTE:  
THIS MAP WAS PREPARED FOR THE PURPOSE  
OF IDENTIFYING THE LOCATION OF THE  
WATER RIGHT ONLY. IT IS NOT INTENDED  
TO PROVIDE DIMENSIONS OR LOCATION  
OF PROPERTY OWNERSHIP LINES.

JOB NO. 2736.03  
DWG NO. E273603.DWG