


CLAIM OF BENEFICIAL USE
FOR: LARRY & LYNNE MASON
BY: DUANE W. KIRBY
DATE: 11-9-06
T26S, R6W, WM
SECTION 22 & 23
APPLICATION NO S86309
PERMIT NO S54353
TAX LOT NO 1700

NOV 15 2006

WATER RESOURCES DEPT
SALEM, OREGON

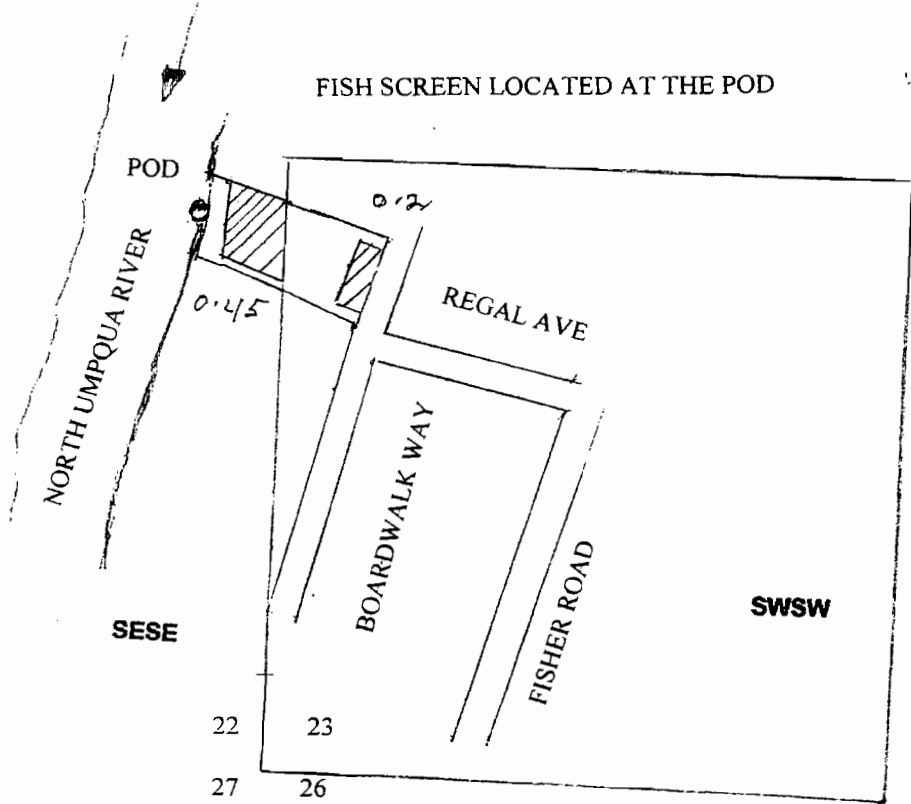

POD is located 1200 ft. N. and 180 ft. W. from the SW corner of Sec. 23

THE PURPOSE OF THIS MAP IS TO IDENTIFY THE LOCATION OF THE WATER RIGHT. IT IS NOT INTENDED TO PROVIDE INFORMATION RELATIVE TO THE LOCATION OF PROPERTY OWNERSHIP BOUNDARY LINES.

