

RECEIVED

SEP 28 1998

WATER RESOURCES DEPT.
SALEM, OREGON

NW 1/4 SE 1/4

NE 1/4 SE 1/4

SW 1/4 SE 1/4

NOTE: AREA IRRIGATED IS 0.24 ACRES



INDICATES AREA TO BE IRRIGATED

FINAL PROOF WATER RIGHTS MAP

UNDER
PERMIT 51592
APPLICATION NO. 71312
17-09-29-4, T.L. 2400
SE 1/4, SE 1/4, SEC 29, T17S, R9W, W.M.
LANE COUNTY, OREGON

FOR: JOHN M. RICKMAN
JACQUELINE RICKMAN
13474 HWY. 36
SWISSHOME, OR 97480

PREPARED BY: WOBBE & ASSOCIATES, INC.
510 KINGWOOD ST./P.O. BOX 1136
FLORENCE, OR 97439
DATE: JULY 6, 1998

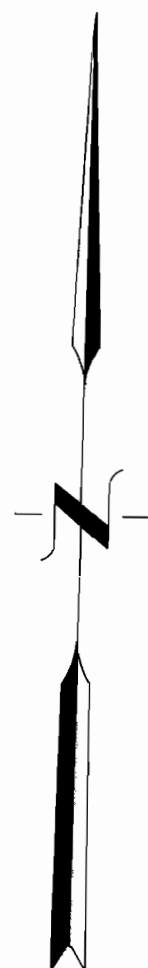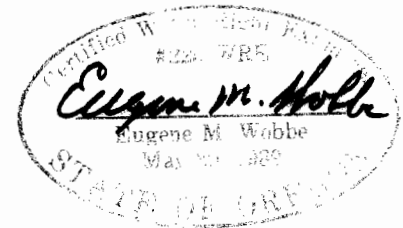

SCALE
1" = 400'

THIS MAP IS FOR THE PURPOSE
OF IDENTIFYING THE LOCATION
OF THE WATER RIGHT ONLY.
THERE IS NO INTENT TO PROVIDE
DIMENSIONS OR LOCATION OF
PROPERTY OWNERSHIP LINES.