




**FINAL PROOF SURVEY**  
 APPLICATION NO. G-12431 PERMIT NO. G-11366  
 IN THE NAME OF  
 JAMES AND PATRICIA EVERED

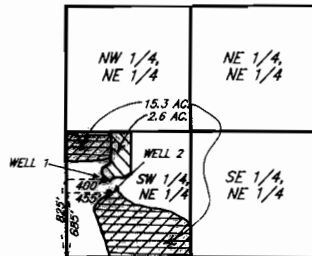

**LEGEND**

- EXISTING "1895" SURFACE WATER RIGHT (15.3 ACRES)
- PRIMARY IRRIGATION FROM WELL (2.6 ACRES)
- SUPPLEMENTAL IRRIGATION FROM WELL (15.3 ACRES)

SW 1/4, NE 1/4, SEC. 12, T15S, R10E, W.M.,  
 DESCHUTES COUNTY, OREGON

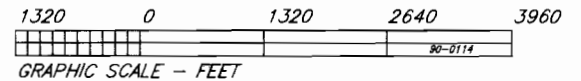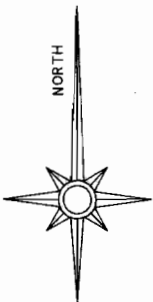

Revised 1/30/96

**RECEIVED**  
 FEB 2 1995  
 WATER RESOURCES DEPT.  
 SALEM OREGON

13 SEPTEMBER 1995

**FRED A. AST, Jr & ASSOCIATES**  
*Land Surveying & Water Rights*  
 351 W. Cascade St. - P.O. Box 751  
 Sisters, Oregon \*\*\*\*\* 97759  
 Phone: (503) 549 - 7851