


T. 4 & 5 S., R. 2 W., W. M.

N

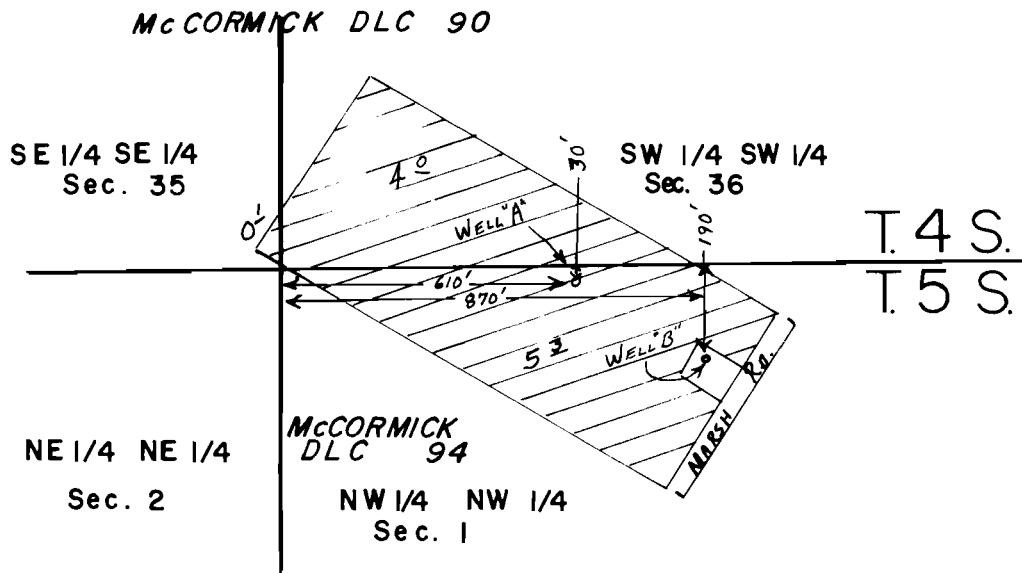

SCALE
1" = 400'



RECEIVED

APR 9 1996

WATER RESOURCES DIV
SALEM, OREGON

FINAL PROOF SURVEY
UNDER

Thompson M. Warren

Application No. G-12915 Permit No. G-11617.....
IN NAME OF

HAROLD M. MILLER

Surveyed 9/30 1995, by T. M. WARREN

A5CS PHOTO
41049-789-148 L