


T.5S. R.1W., W.M

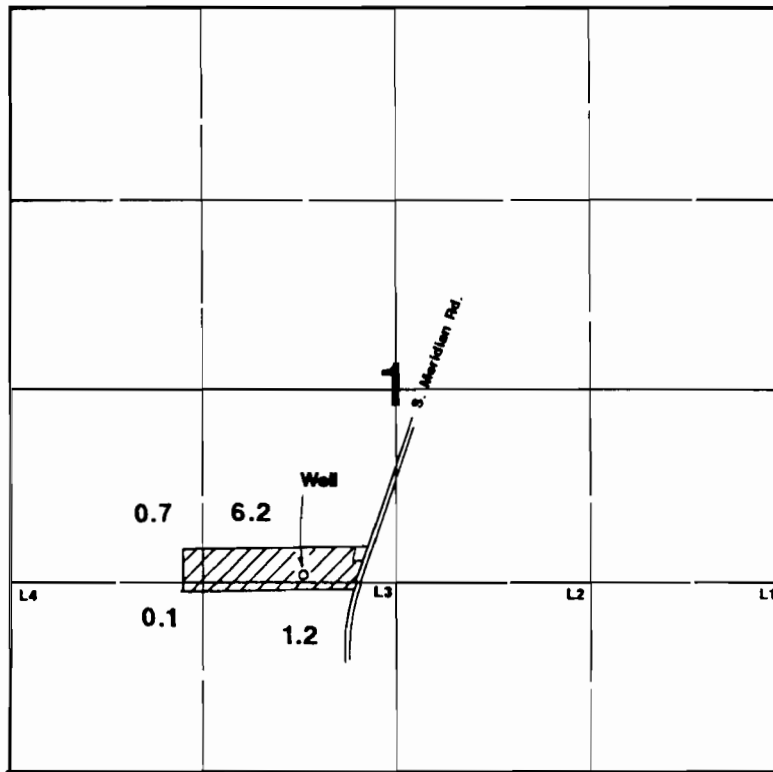

Well is located 1360'N & 2032'E from the SW corner of Section 1.

Final Proof Survey

Application #: G-13647 Permit #: G-11966

In Name Of

Richard & Johanna Eggimann

Surveyed on June 22, 1999 by JM Schuette

This Map Was Prepared For The Purpose Of Identifying The Location Of A Water Right Only And Is Not Intended To Provide Legal Dimensions Or Location Of Property Ownership Lines.

