

T. 27 S., R. 13 W.W.M. RECEIVED

SECTION 17

THIS MAP IS FOR THE PURPOSE OF LOCATING THE WATER RIGHT ONLY AND IS NOT INTENDED TO PROVIDE LEGAL DIMENSIONS OR LOCATIONS OF PROPERTY OWNERS' LINES. WATER RESOURCES DEPT. 1995

PERMIT TO APPROPRIATE #51032
APPLICATION #69644 - JUNE 16, 1988

PERMIT TO STORE # R - 11236
APPLICATION #69643 - JUNE 16, 1988


SCALE - 1" = 1,320'



- ① EXISTING RESERVOIR -
SURFACE AREA = 12.28 A.C.
CAPACITY = 3.82 MG
- ② EXISTING EARTHEN DAM
LENGTH = 600' - WIDTH = 15' (TOP)
HEIGHT = 8.2'
- ③ POINT OF DIVERSION #1 - 1,480'
SOUTH AND 1,164' EAST OF WEST 1/16
CORNER, NORTH LINE SECTION 17.
- ④ POINT OF DIVERSION #2 - 1,484'
SOUTH AND 1,943' EAST OF WEST 1/16
CORNER, NORTH LINE SECTION 17.

▨ AREA OF WATER USAGE IN
ACRES PER 1/4, 1/4 SECTION.

- Ⓐ 0.08 A.C.
- Ⓑ 0.5 A.C.
- Ⓒ 7.48 A.C.
- Ⓓ 2.5 A.C. (FUTURE)
- Ⓔ 2.5 A.C. (FUTURE)

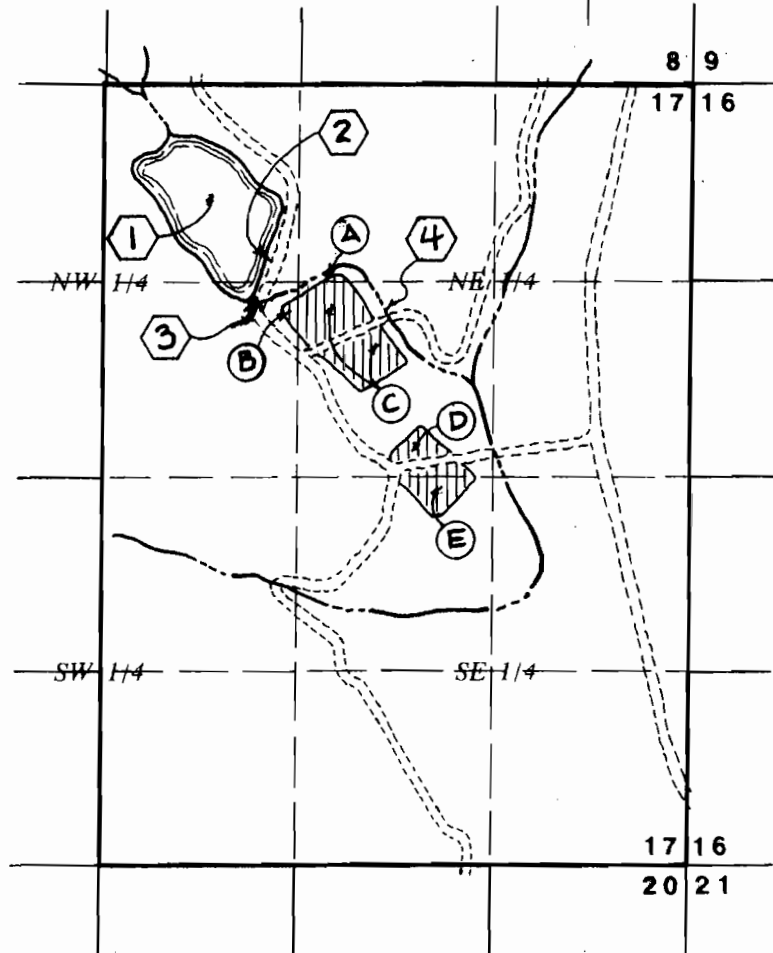


WATER RIGHTS MAP

E1/2 NW1/4, E1/2 SW1/4, NE1/4, and SE1/4, SECTION 17,
T 27 S, R 13 WWM, COOS COUNTY, OREGON.

for MAURICE MORGAN



edward w. riley
ARCHITECT-ENGINEER
AIRPORT TERMINAL BLDG.
NORTH BEND, OREGON 97459

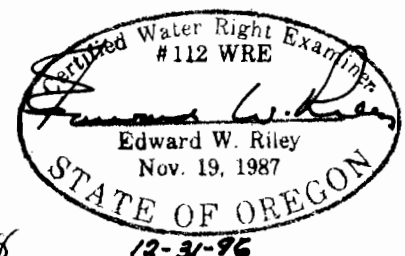

Amended by WRD staff, 5-16-08
71008

12-31-96