
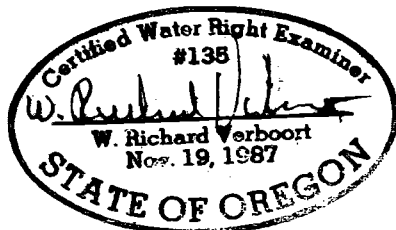


RECEIVED

MAR 09 1995
WATER RESOURCES DEPT.
2 SALEM, OREGON

SECTION 34, T.2N., R.2W., W.M.
WASHINGTON COUNTY OREGON

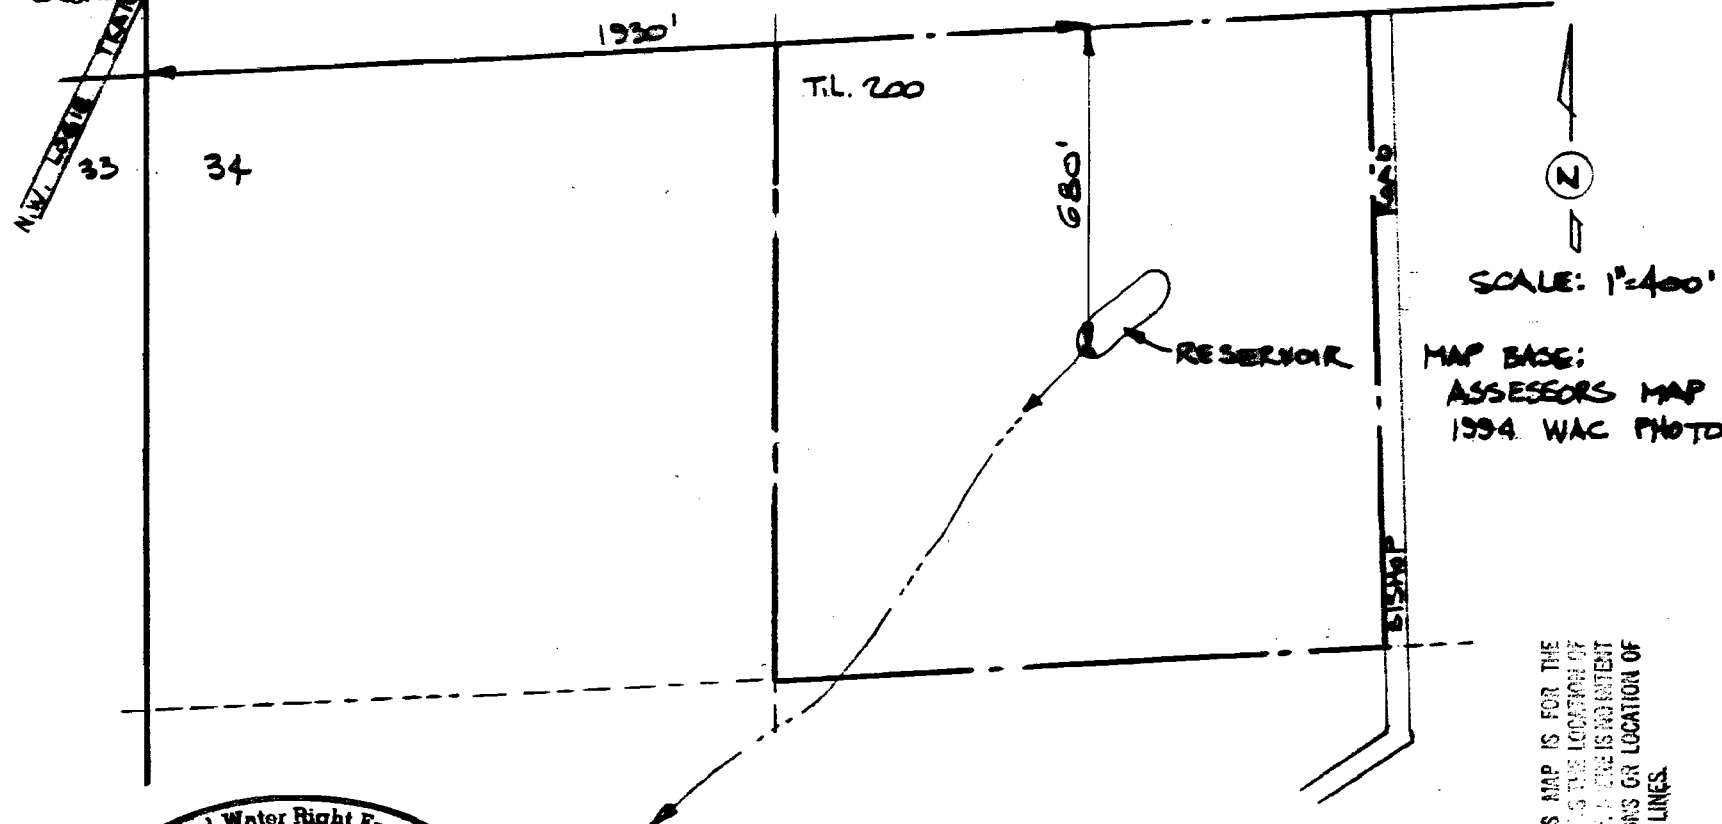

FINAL PROOF SURVEY
UNDER
APPLICATION R-70441 PERMIT R-11419
SURVEYED 2/28/95

PREPARATION OF THIS MAP IS FOR THE
PURPOSE OF IDENTIFYING THE LOCATION OF
THE WATER RIGHT ONLY. THERE IS NO INTENT
TO PROVIDE DIMENSIONS OR LOCATION OF
PROPERTY OWNERSHIP LINES.

PAULE L. LOTTIN & MARK A. RAUCH
13707 BISHOP ROAD
HILLSBORO, OR 97124

	date
designed	WRY 3-25
drawn	JER 3-25
checked	WRY 3-25
drawing no.	95-A-02
sheet no.	1/1

VERBOORT ENGINEERING
AGRICULTURE-CIVIL-WATER RESOURCES
HILLSBORO, OREGON