
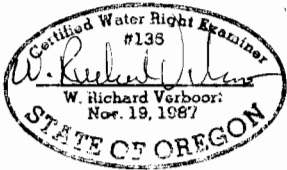


SECTION 14 & 15, T.4 S., R.2 W., W.M., MARION COUNTY, OREGON

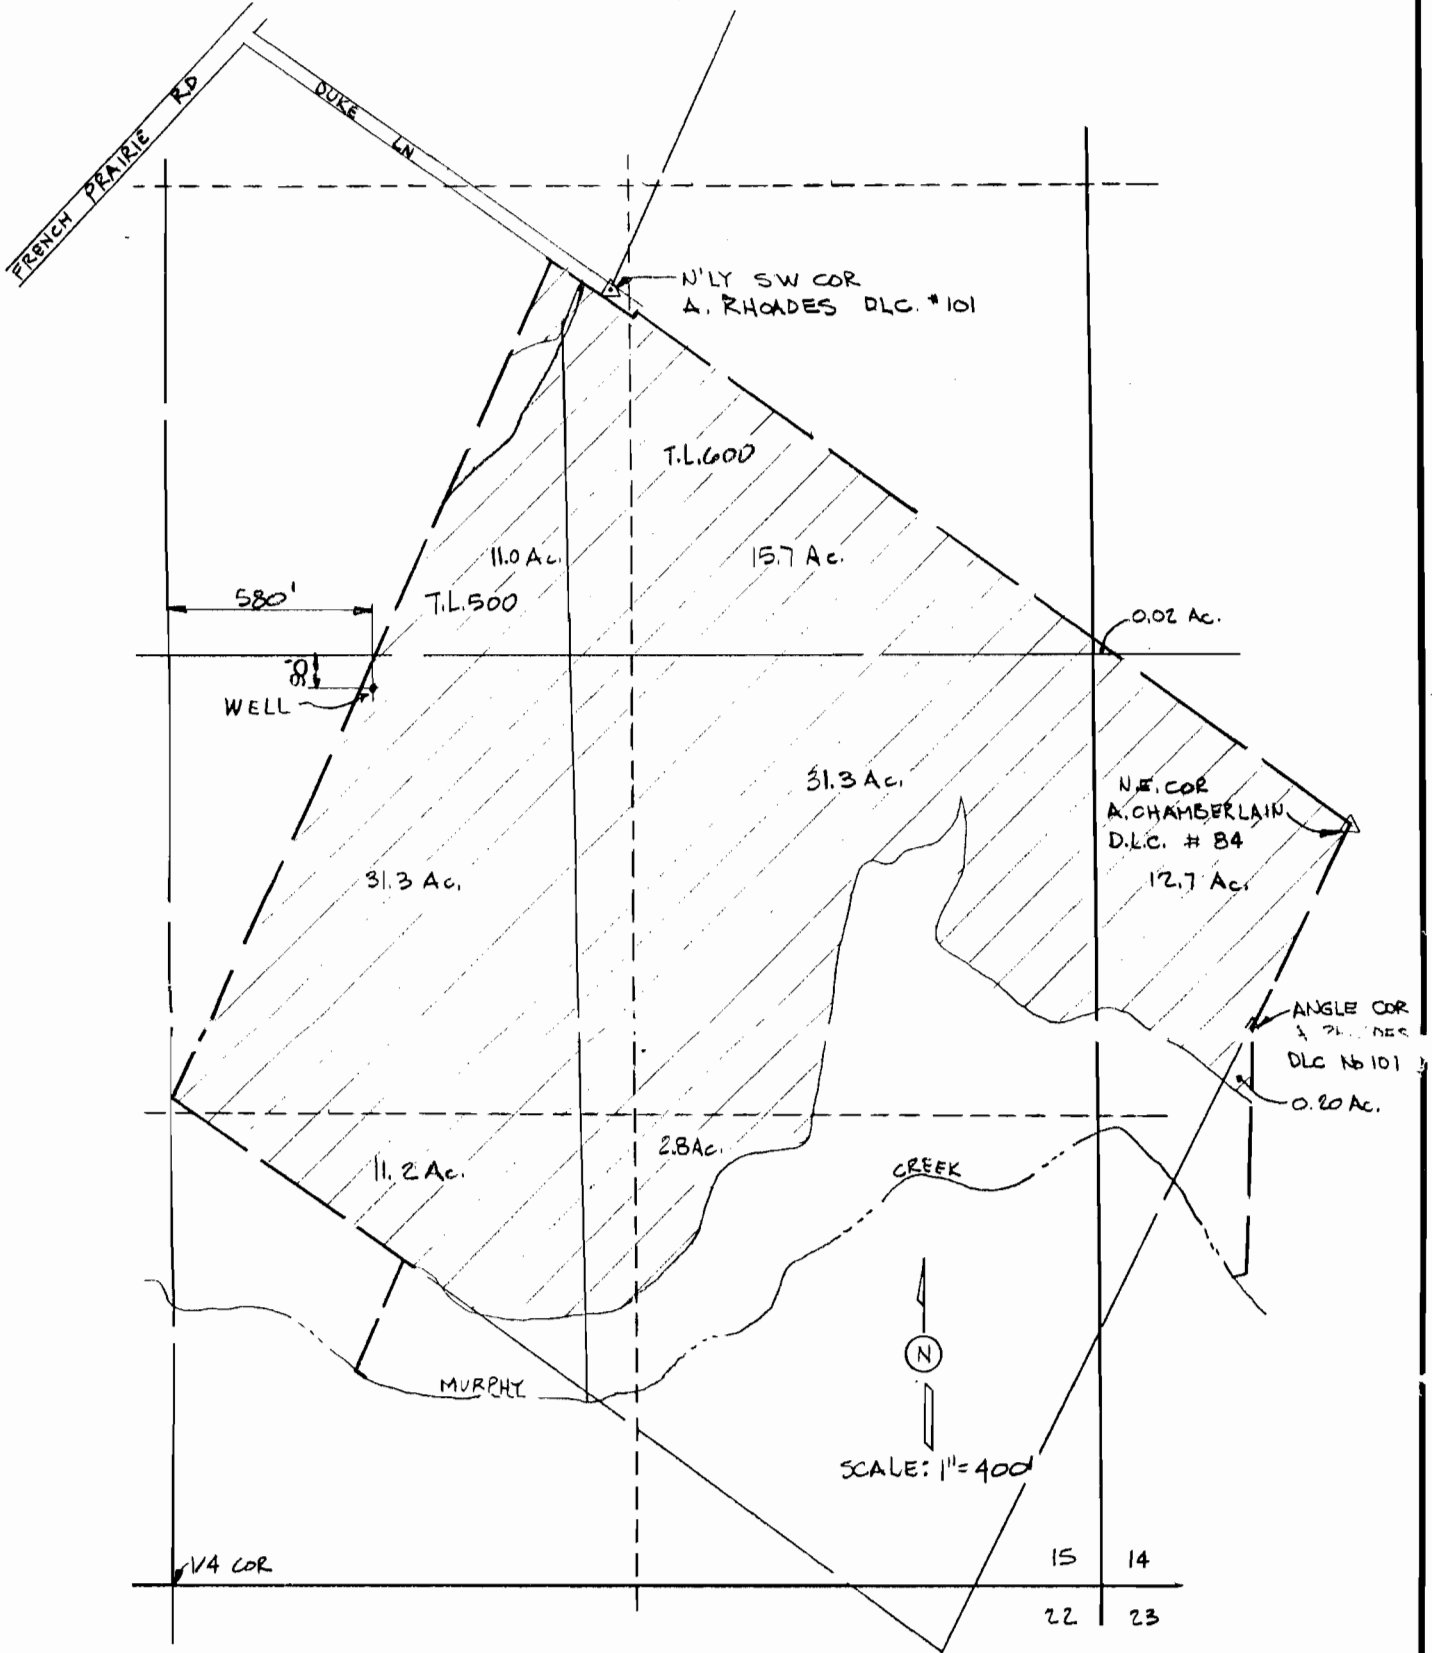

SURVEYED AUGUST 8, 1995
 APPLICATION G-12121
 PERMIT - G-11387
 MAP BASE:
 1993 WAC PHOTO
 ASSESSORS MAP

PREPARATION OF THIS MAP IS FOR THE
 PURPOSE OF IDENTIFYING THE LOCATION OF
 THE WATER RIGHT AND ANY PERMITS IN INTEREST
 TO PROVIDE DIMENSIONS OR LOCATION OF
 PROPERTY OWNERSHIP LINES.

VERBOORT ENGINEERING
 AGRICULTURE • CIVIL • WATER RESOURCES
 HILLSBORO, OREGON

	by	date
designed	WRV	8-9-95
drawn	JER	8-9-95
checked	WRV	8-9-95
drawing no.	95-B-11	
sheet no.	1/1	

FINAL PROOF SURVEY
 FOR
 KAUFMANN FARMS
 19533 FRENCH PRAIRIE RD.
 WOODBURN, OR