


T.4S. R.2W., W.M.



4" = 1 MI.

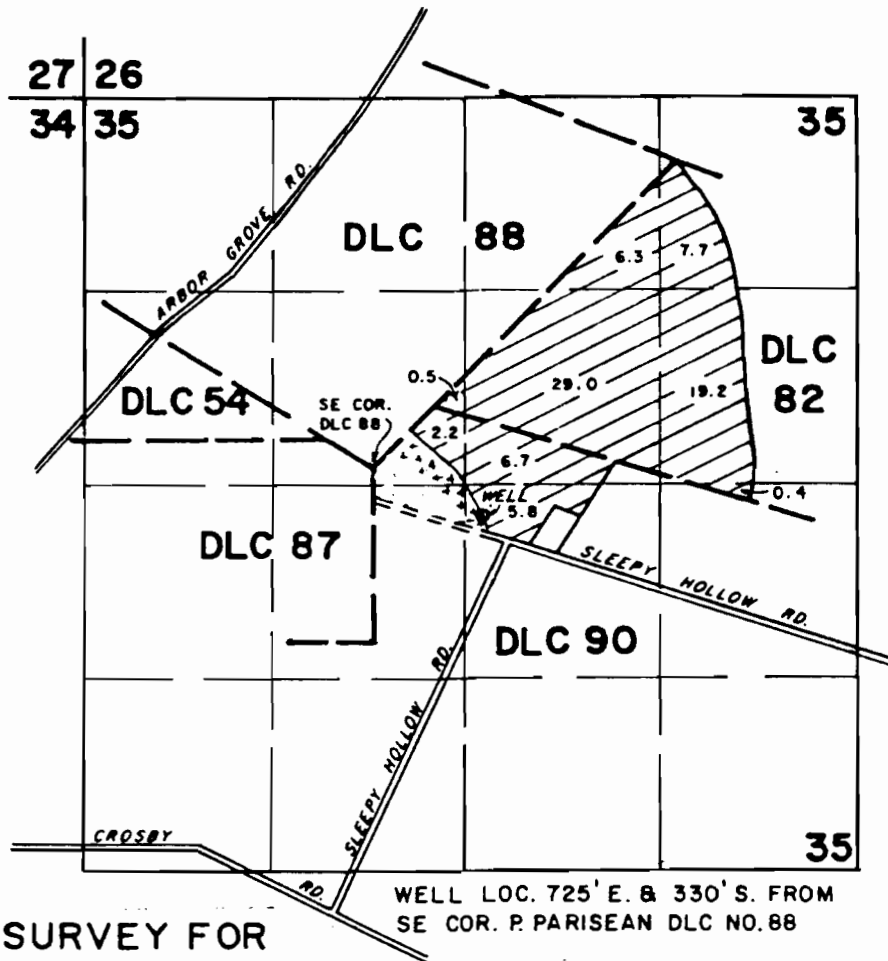

WELL LOC. 725' E. & 330' S. FROM SE COR. P. PARISEAN DLC NO. 88

FINAL PROOF SURVEY FOR
APPL. NO.- G-12264 PER. NO. G-11262

STAN DANSKY

SURVEYED ON SEPT. 7, 1990
INSPECTED JULY 25, 1995 BY

THIS MAP WAS PREPARED FOR THE PURPOSE OF IDENTIFYING THE LOCATION OF A WATER RIGHT ONLY AND IS NOT INTENDED TO PROVIDE LEGAL DIMENSIONS OR LOCATION OF PROPERTY OWNERSHIP LINES.

